

Name Duthet Realty Trust

Service No. 87

Address 64 Baskin Rd.

Location

Kind of Pipe

Size

Size of Main

~~Replacement~~ - New Service

Location *Comp 7-5-60*

Date	Material	Amount	Total	Date	Amount
5-21-60	Labor	10 88		5-31-60	150 00
6-2-60	"	34 24		7-5-60	26 80
		45 12			123 20
	10% O.H.	4 51	49 63		
	62' 6" Transite pipe @78		48 36		
	1 22 1/2" Transite Bend		6 21		
	2 Hrs. Town Shovel @6.50		13 00		
	2 Hrs. Trucking @3.00		6 00		
			123 20		


DATE _____

TOWN OF LEXINGTON — BOARD OF PUBLIC WORKS

SEWER DIVISION

Sketch of Service Here

64

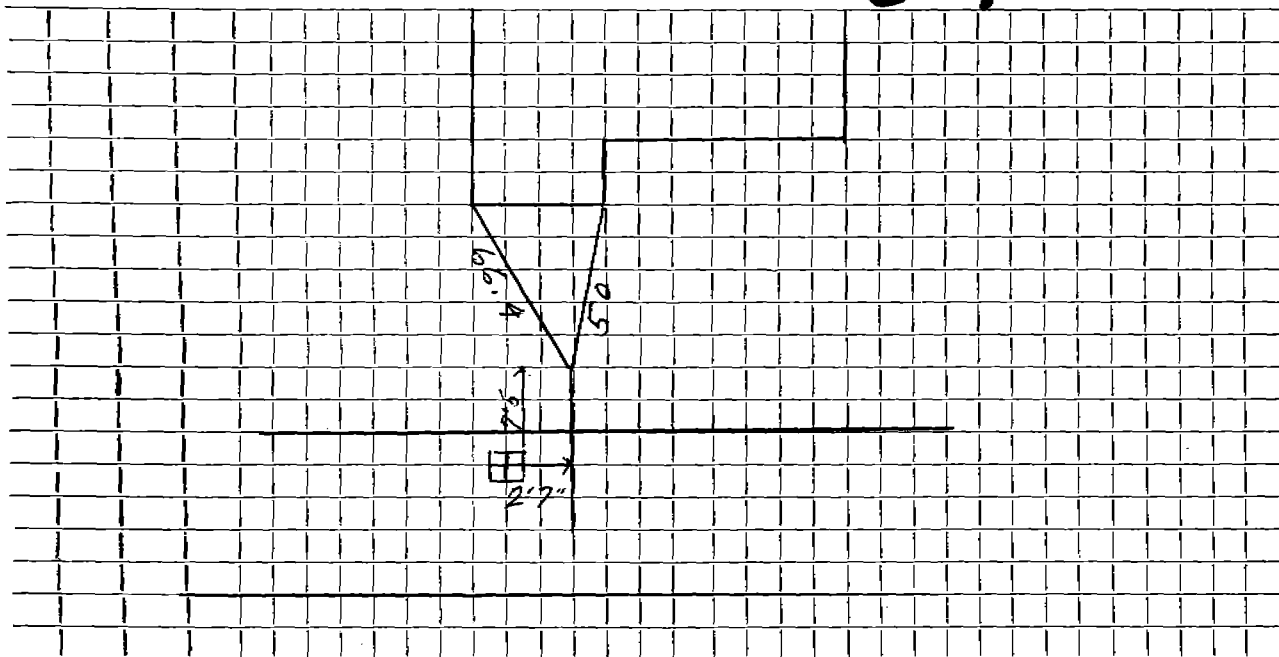

Connection made in Street. Work completed

Remarks: ... Elev. 2.42.15. Sta. 37+53