

Name James J. Pates Jr.

Service No. 148

Address 10 Bates Road

Location

Kind of Pipe AC

Size 6"

Size of Main 8"

Repair—Renewal—New Service Valeri #2785

Location AUG 16 1976


Date		Material		Amount	Total	Date	Amount
<del>7-24</del>	<del>75</del>	<del>26'-6"</del>	<del>AC</del>	<del>at 10.00 =</del>	<del>260.00</del>	12-2-5	Deposit 260 00
12/11/75	90'	6"	Transite Pipe				
	10'	4"	Cast Iron Pipe			7-24-75	
						26' 6" AC	

DATE \_\_\_\_\_

TOWN OF LEXINGTON — BOARD OF PUBLIC WORKS  
SEWER DIVISION

Sketch of Service Here

10

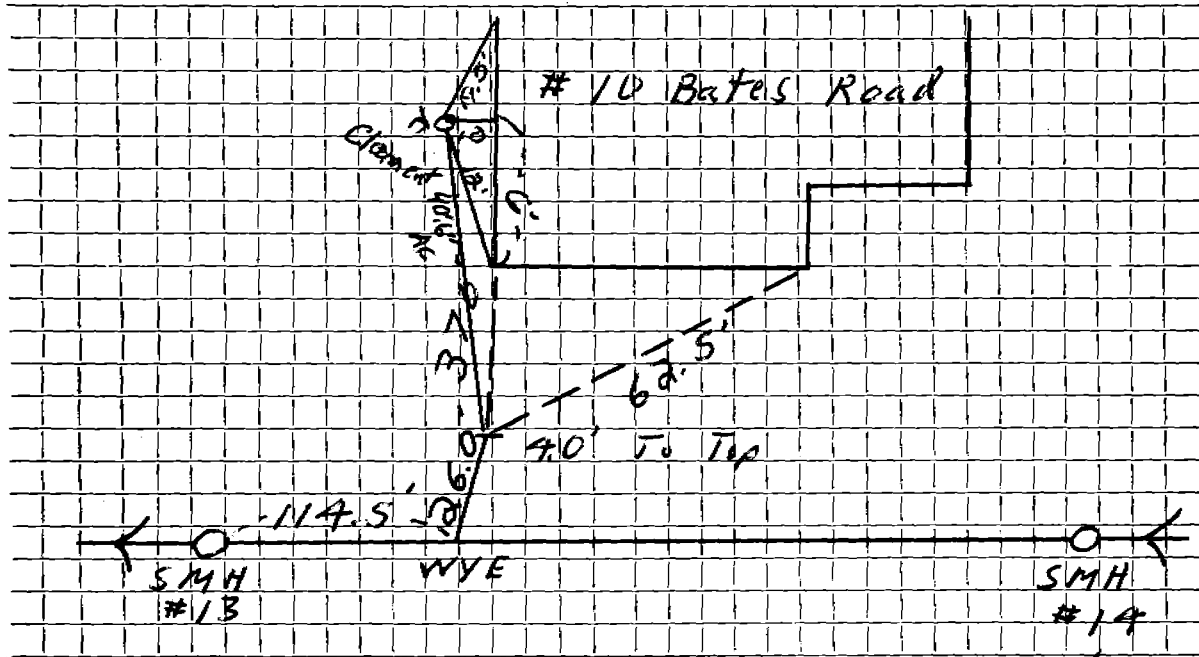

Connection made in <sup>#10</sup> Bates Rd. Street. Work completed 12/11/75

Remarks: .....

.....

.....