

Name Jacek A. Mroczkowski

Service No. 28

Address #11 Bates Road

Location

Kind of Pipe AC

Size 6"

Size of Main 8"

Repair—Renewal—New Service Valeri Const. #2953

Location AUG 16 1976


Date	Material	Amount	Total	Date	Amount
<del>7-23-75</del>	<del>51'-6" AC at</del>	<del>10.00</del>	<del>210.00</del>	5/5/76	Deposit 210 00
5/7/76	84.5' 6" Transite Pipe				
	10' 4" Cast Iron Pipe			7-23-75	
					21' 6" AC

.S.N. 18501

DATE \_\_\_\_\_

TOWN OF LEXINGTON — BOARD OF PUBLIC WORKS  
SEWER DIVISION

Sketch of Service Here

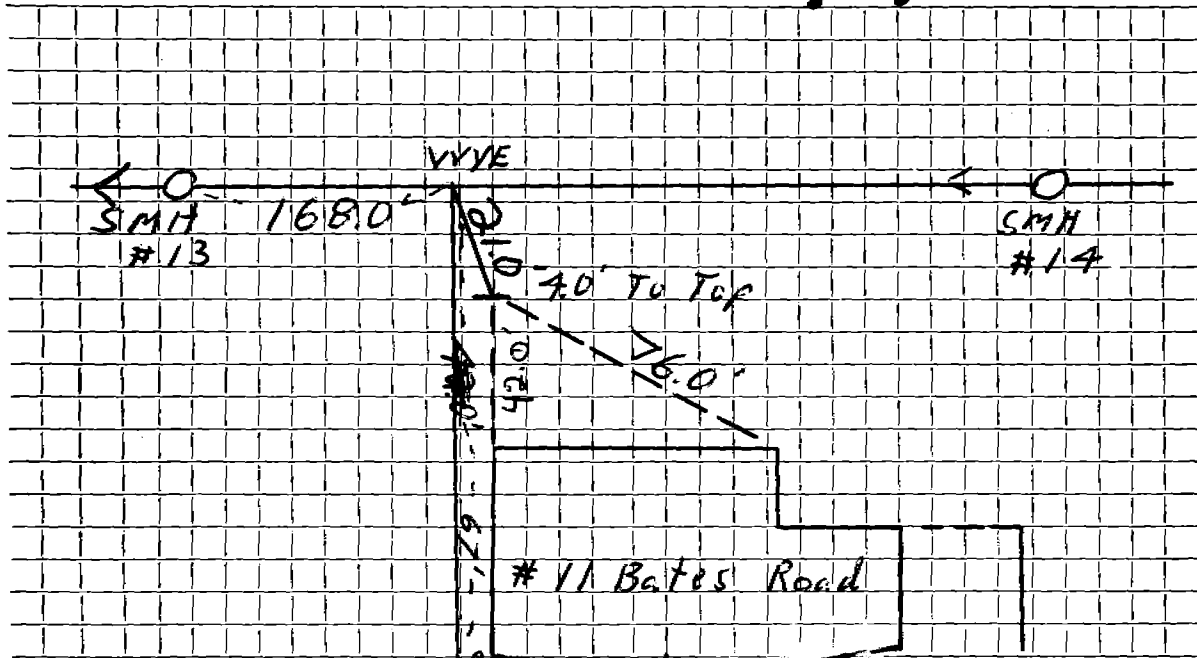

Connection made in Bates ..... Work completed ..... SMH #11 5/7/76

Remarks: .....

.....

.....