


DATE _____

TOWN OF LEXINGTON — BOARD OF PUBLIC WORKS
SEWER DIVISION

Sketch of Service Here

16

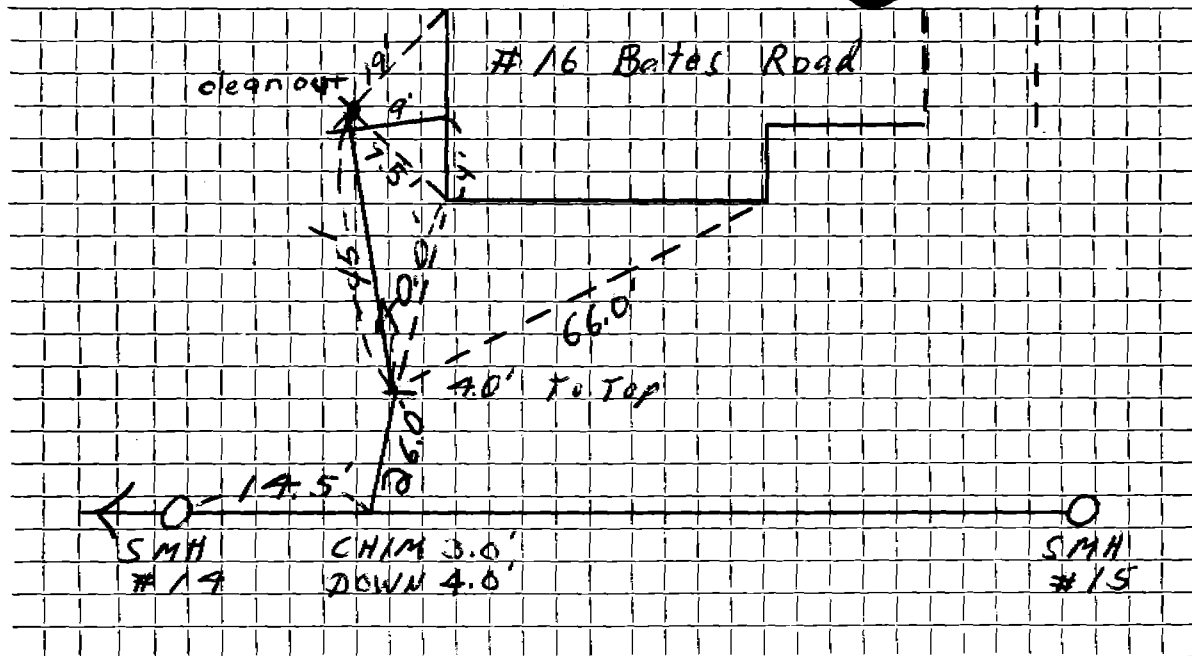

Connection made in ^{#16} Bates Rd. Street. Work completed 12/12/75.

Remarks:

.....

.....