

Name Debo Properties

Service No.

Address 17 Bates Rd.

Location

Kind of Pipe

Size

Size of Main

Repair—Renewal—New Service

Location

Date

Material

Amount

Total

Date

Amount

Sept 2001


80' 6" PVC

1- 6" x 6" A.C. to PVC Fernco

DATE \_\_\_\_\_

TOWN OF LEXINGTON — BOARD OF PUBLIC WORKS  
SEWER DIVISION

Sketch of Service Here

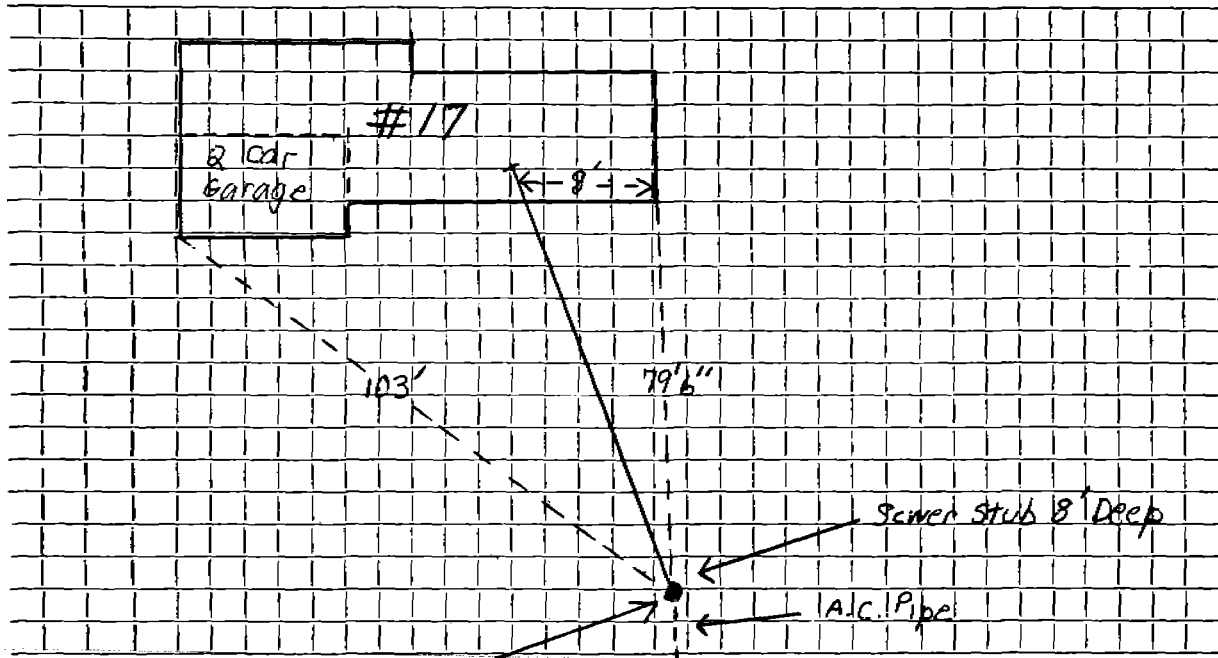

Connection made in ..... Street. Work completed .....

Remarks: .... Pipe offset at Stub. Bend made up with Ferraco .....

.....  
.....