

Name Judith Bellizia

Service No. 14

Address 18 Bates Road

Location

Kind of Pipe AC

Size 6"

Size of Main 8"

~~REMOVED~~ ~~REMOVED~~ - New Service Ross Mechanical Const. #3223


Location MAY 21 1979

Date	Material	Amount	Total	Date	Amount	
8-1	75 31' 6" AC at	10.00 =	310.00	4-19-79	Deposit	310.00
4/20/79	47' 6" Transite Pipe					
	7' 4" Cast Iron Pipe			8-1- 75		
					31' 6" AC	

DATE _____

TOWN OF LEXINGTON — BOARD OF PUBLIC WORKS
SEWER DIVISION

Sketch of Service Here **18**

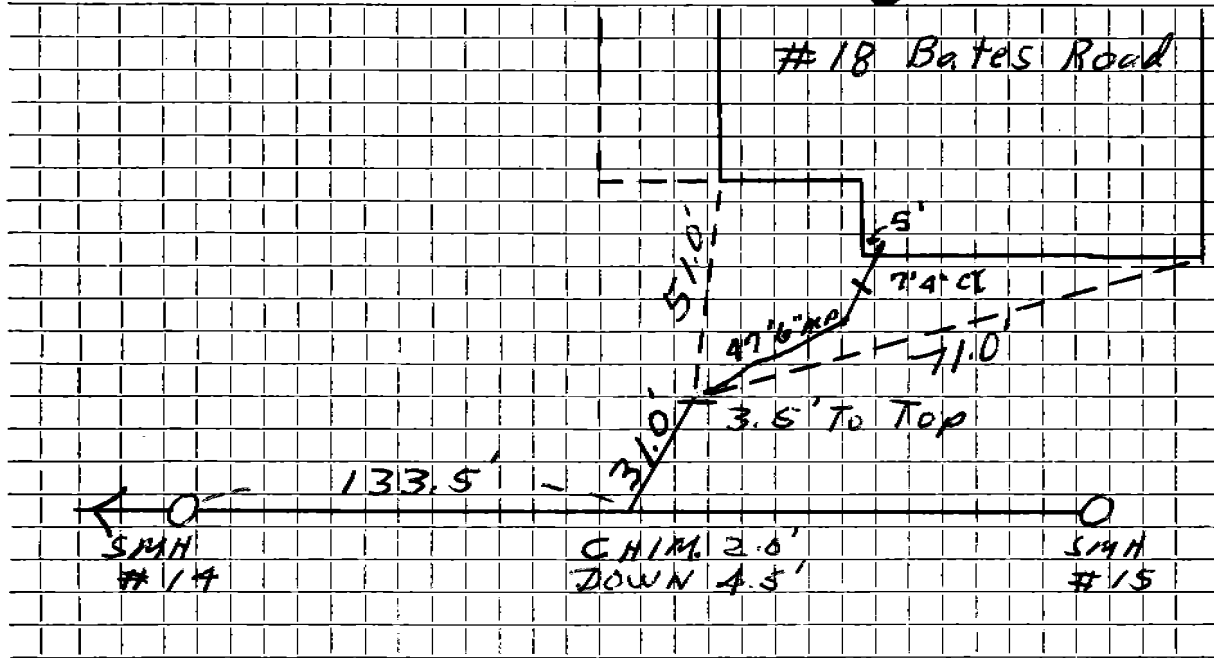

Connection made in Bates Street. Work completed

Remarks:

.....

.....