


TOWN OF LEXINGTON — BOARD OF PUBLIC WORKS
SEWER DIVISION

DATE 5/21

Sketch of Service Here

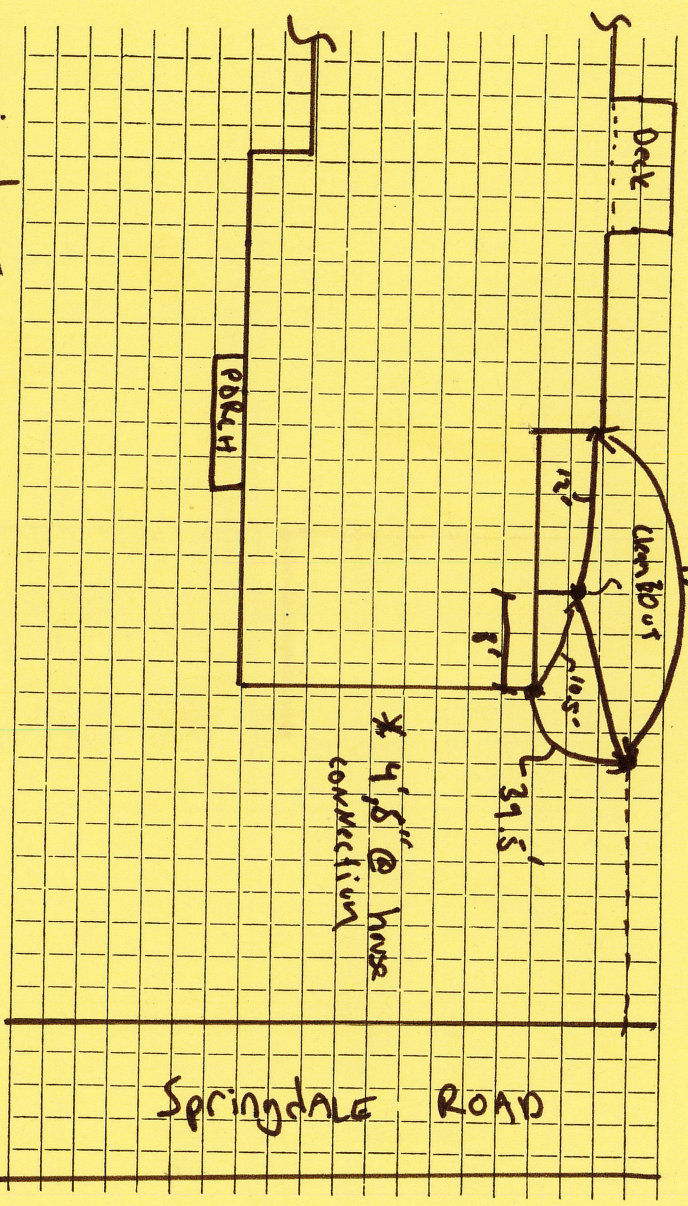

Connection made in Springdale

Street

Work completed

Remarks:

Springdale Road

Name Edward W. & Faith E. Pelikan

Service No. 169

Address 7 Bates Road

Location

Kind of Pipe AC

Size 6"

Size of Main 8"

Repair—Renewal—New Service Trebino Construction #2798


Location AUG 16 1976

| Date | | Material | Amount | Total | Date | | Amount |
|---------|-----|-------------------|-----------|----------|---------|---------|--------|
| 7-30 | 75 | 43'-6" AC at | \$10.00 = | \$430.00 | 12/17/5 | Deposit | 430.00 |
| 4/29/76 | 95' | 6" Transite Pipe | | | | | |
| | 10' | 4" Cast Iron Pipe | | | | | |
| | | | | | | | |
| | | | | | | | |
DATE _____

TOWN OF LEXINGTON — BOARD OF PUBLIC WORKS
SEWER DIVISION

Sketch of Service Here **7**

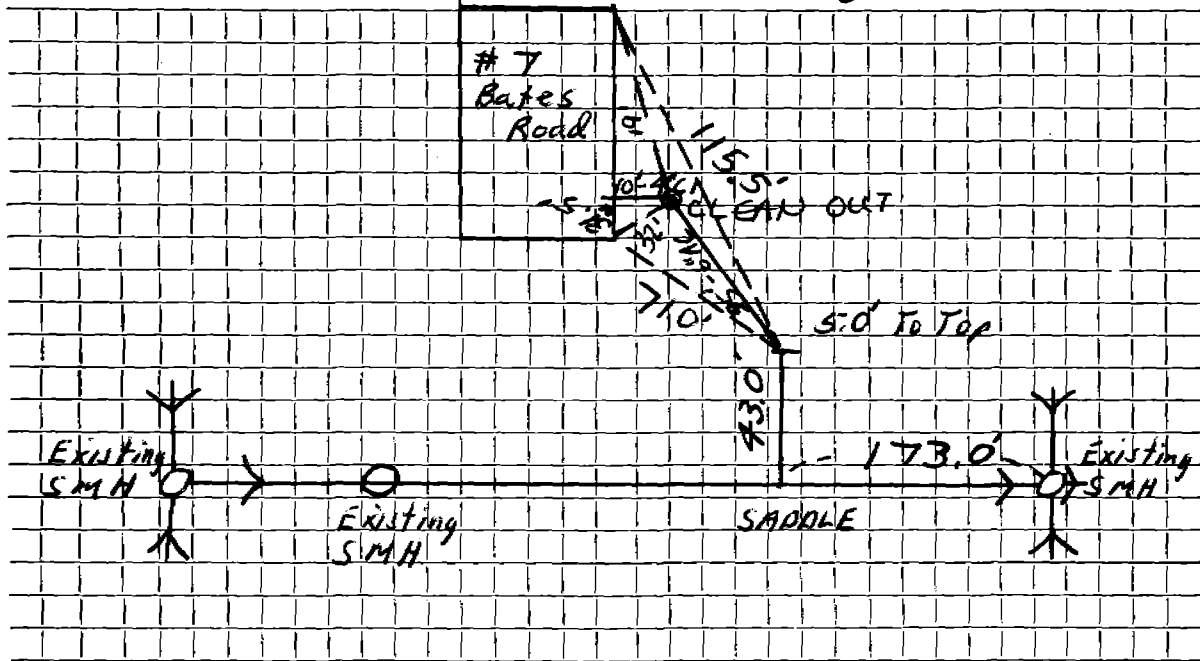

Connection made in Springdale Road Street. Work completed 4/29/76

Remarks:

.....

.....