




DATE \_\_\_\_\_

TOWN OF LEXINGTON — BOARD OF PUBLIC WORKS  
SEWER DIVISION

Sketch of Service Here

8

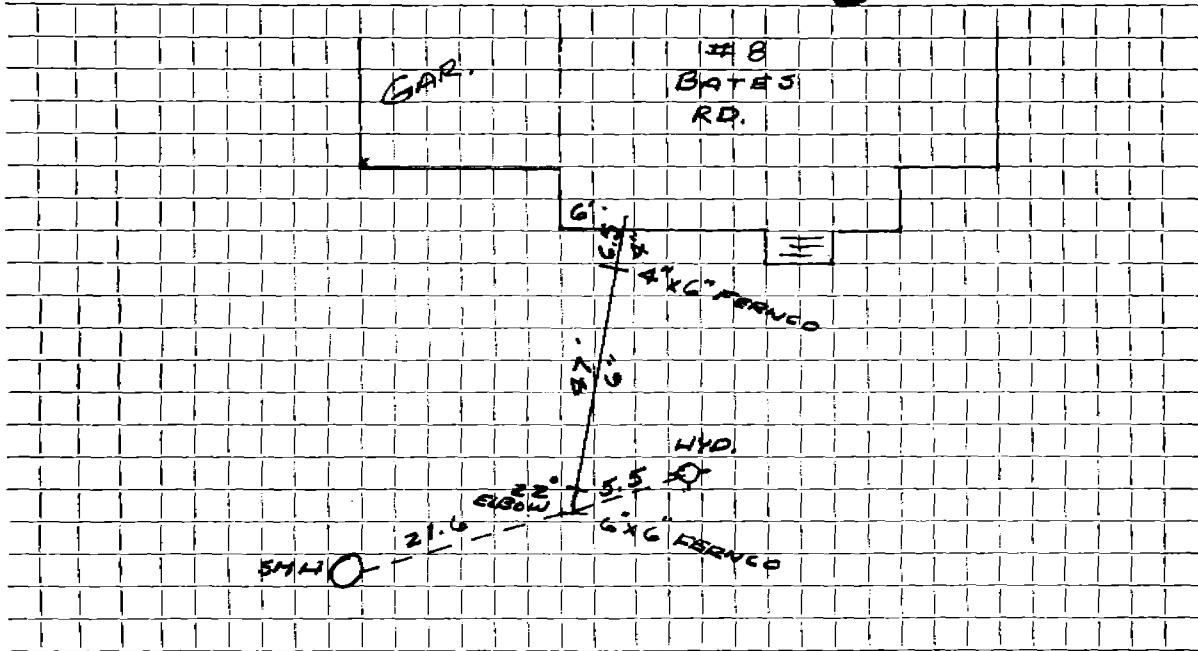

Connection made in BATES RD. Street. Work completed .....

Remarks: OLD HSE DEMOLISHED - USE NEW TIES