


DATE 8/12/19

TOWN OF LEXINGTON — BOARD OF PUBLIC WORKS
SEWER DIVISION

Sketch of Service Here

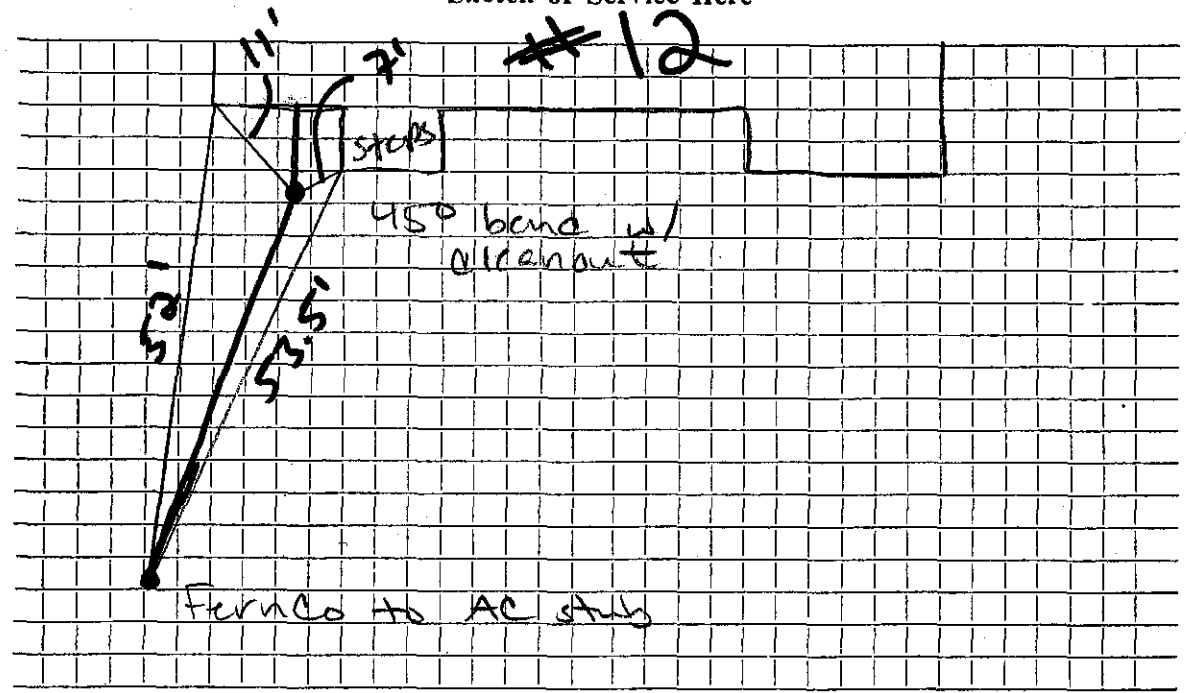

Connection made in Bates Rd Street. Work completed

Remarks:

.....

.....