

Name Charles G. Ruggiero

Service No. 9

Address #10 BATTLEGREEN RD.

Location

Kind of Pipe

Size

Size of Main

~~Repair-Renewal~~—New Service Lexington Sewerage #547

Location

JUL 24 1967

Date	Material	Amount	Total	Date	Amount	
Sept 20 '57	Labor	35 87		3-6-67	Deposit	134 56
	10% Overhead	3 59	39 46			
	20'-6" Transite Pipe @.702		14 04			
	1 hr. Hough Loader @ 3.00		3 00		Non Charge	
	2 hrs. Northwest Shovel @ 6.50		13 00		Labor	17 27
	1/2 hr. Compressor @ 3.00		1 50		Ins. & other items	3 29
	2 hrs. Trucking @.75		1 50		Hough Loader	13 00
			72 50		Northwest Shovel	17 00
			<u>62.06</u>		Trucking	11 50
			134. 56			62 06
3-25-67	18' 6" Transite pipe					
	Labor					
	Installed by Contractor-Bill when connected					
HP-6411						

TOWN OF LEXINGTON—DEPT. OF PUBLIC WORKS
SEWER DIVISION

DATE

NO.

The undersigned applies for the construction of a particular sewer connecting No. Street and hereby agrees to comply with the Rules and Regulations governing the construction and use of Particular Sewers, as now or at any future time established by the Board of Selectmen.


Am't of estimate \$.....

Am't Paid \$.....

..... Owner

Sketch of Service Here

10

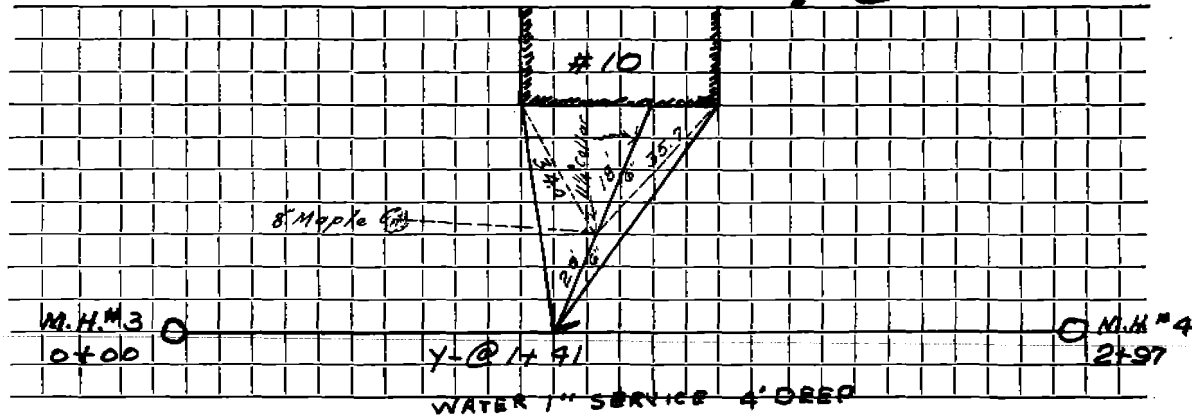

Connection made in Street. Work completed 19..

Remarks: