

Name Raymond D. Lynch

Service No. 110

Address* 15 BATTLEGREEN RD.

Location

Comm. 11-18-57

Kind of Pipe

Size

Size of Main

Repair--Renewal--New Service

Location

Date	Material	Amount	Total	Date	Location	Amount
8/16/57	Labor	88 79		8-9-57	Deposit	\$ 150 00
	10% overhead	8 88	97 67	12-9-57	paid	5 13
	43' - 6" Transite pipe @ .70		30 10			155 13
	2 - 11 1/4 6" Transite. bends @ 2.24		4 48			
	1 - 6" Clay Elbow		1 88			
	3 hrs. Town Shovel @ 6.50		19 50			
	2 hrs. Trucking @ .75		1 50			
			155 13			
					Bill sent 11-21-57	
	Labor					
				7/5/68	Solids	

TOWN OF LEXINGTON—DEPT. OF PUBLIC WORKS

SEWER DIVISION

DATE

NO.

The undersigned applies for the construction of a particular sewer connecting No.
Street and hereby agrees to comply with the Rules and Regulations governing the construction and use of Particular
Sewers, as now or at any future time established by the Board of Selectmen.


Am't of estimate \$.....

Am't Paid \$.....

..... Owner

Sketch of Service Here

15

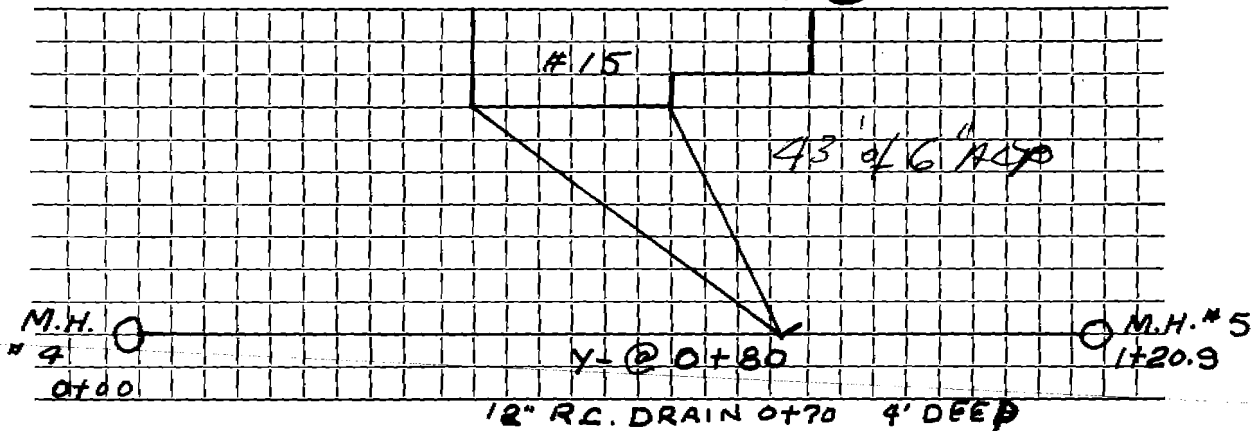

Connection made in Street. Work completed 19..

Remarks: