

Name Mrs. Myrtle Lovering

Service No. 108

Address #16 BATTLEGREEN RD.

Location

Comm. 10-28-57

Kind of Pipe

Size

Size of Main

~~Repair Renewal~~ - New Service

Location

Date	Material	Amount	Total	Date	Amount
8/26/57	Labor	118 73		8-8-57	Deposit # 200 00
	10% overhead	11 87	130 60	11-25-57	Paid 30 18
	71'-6" Transite pipe @.70		49 70		\$ 230 18
	1-6" Clay Elbow		1 88		
	14x3 Patch		14 00		
	5 hrs. Town Shovel @ 6.50		32 50		
	2 hrs. Trucking @ .75		1 50		
			230 18		
	Labor				
					Bill sent 10-30-57
					\$ 30.18

TOWN OF LEXINGTON—DEPT. OF PUBLIC WORKS

SEWER DIVISION

DATE .....

NO. ....


The undersigned applies for the construction of a particular sewer connecting No. .... Street and hereby agrees to comply with the Rules and Regulations governing the construction and use of Particular Sewers, as now or at any future time established by the Board of Selectmen.

Am't of estimate \$.....

Am't Paid \$.....

..... Owner

Sketch of Service Here **16**

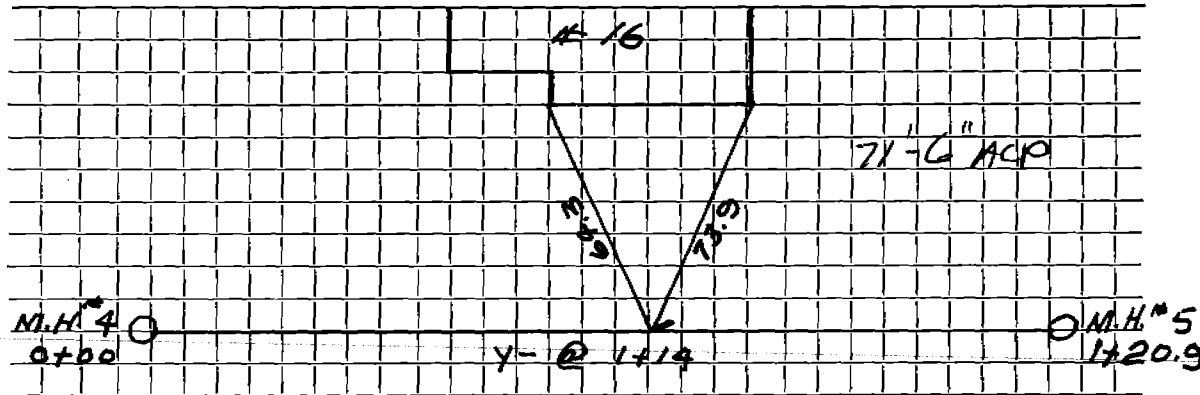

Connection made in ..... Street.

Work completed ..... 19..

Remarks: