

Name Paul V. & Madelene A. Roberts

Service No. 104

Address # 17 BATTLEGREEN RD.

Location Comm. 10-28-57

Kind of Pipe Size Size of Main

~~REPAIR/RENEWAL~~ New Service Location

Date	Material	Amount	Total	Date	Amount	
8-28-57	Labor	52.21		8-6-57	Deposit	\$ 150.00
	10% O.H.	5.22	57.43	10-28-57	Refund	19.54
	45' 6" Transite @.70		31.50			<u>\$ 130.46</u>
	1 6" 45° Bend Long		7.60			
	1 6" 22½° Bend Long		6.21			
	3 6" 22½° Elbows @ 2.24		6.72			
	3 hrs. Town Shovel @ 6.50		19.50			
	2 hrs. Trucking @.75		<u>1.50</u>			
			130.46			
	Labor					

TOWN OF LEXINGTON—DEPT. OF PUBLIC WORKS

SEWER DIVISION

DATE.....

NO.

The undersigned applies for the construction of a particular sewer connecting No.....
 Street and hereby agrees to comply with the Rules and Regulations governing the construction and use of Particular
 Sewers, as now or at any future time established by the Board of Selectmen.


Am't of estimate \$.....

Am't Paid \$.....

..... Owner

Sketch of Service Here

17

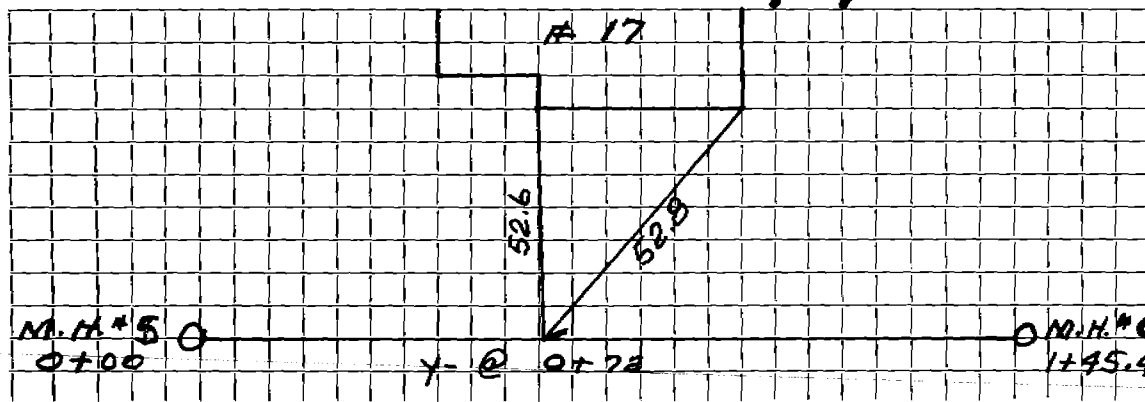

Connection made in Street.

Work completed.....19..

Remarks: