

Name Henry Toczylowski

Service No. 45

Address #19 BATTLEGREEN RD.

Location

Kind of Pipe

Size

Size of Main

~~Repair~~ ~~Renewal~~ — New Service Valeri #2498

Location

AUG 16 1976

Date	Material	Amount	Total	Date	Amount	
Sept. 16 '57	Labor	40 38		7/5/74	Deposit	176.21
	10% Overhead	4 04	44 42			
	19'-6" Transite Pipe @ .702		13 34			
	2 long 45 degree Bend @ 7.60		15 20			
	1 hr. Compressor @ 3.00		3 00		Labor	18 65
	2 hrs. Hough Loader @ 3.00		6 00		Insurance & other items	13 60
	1 hr. Northwest Shovel @ 6.50		6 50		Hough Loader	18 00
	2 hrs. Trucking @ .75		1 50		Northwest Shovel	23 50
			89 96		Trucking	12 50
7/11/74	39' 6" Transite Pipe					86 25
	10' 4" Cast Iron Pipe					
	Labor					
	Service installed by Contractor to Curb-					
	Bill when connected					
			\$ 176.21			

TOWN OF LEXINGTON—DEPT. OF PUBLIC WORKS
SEWER DIVISION

DATE.....

NO.

The undersigned applies for the construction of a particular sewer connecting No.....
Street and hereby agrees to comply with the Rules and Regulations governing the construction and use of Particular
Sewers, as now or at any future time established by the Board of Selectmen.


Am't of estimate \$.....

Am't Paid \$.....

..... Owner

Sketch of Service Here

19

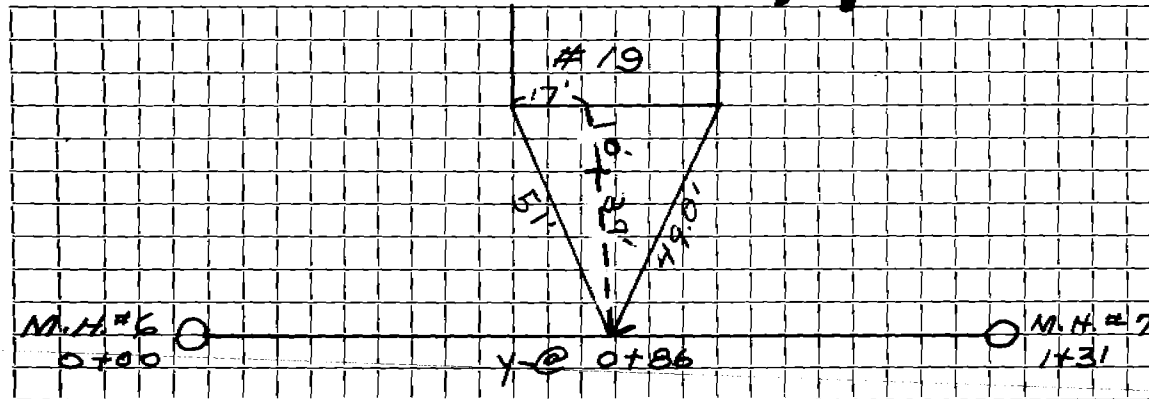

Connection made in # Battle Green Rd. Street.

Work completed 7/11/74.....19..

Remarks: