

Name Lawrence Harding

Service No. 152

Address 21 BATTLEGREEN RD.

Location Comm. 10-28-57

Kind of Pipe

Size

Size of Main

~~Repair~~ New Service

Location

Date	Material	Amount	Total	Date	Amount
9-19-57	Labor	115.80		9-16-57	Deposit \$ 150.00
	10% O.H.	11.58	127.38	5-14-59	Paid 44.48
	40' 6" Transite @.70		28.00		194.48
	1 6" 1/8 Bend Long		7.60		NON CHARGE
	2 hrs. Hough @ 3.00		6.00		Labor 57.33
	5 hrs. Northwest Shovel @ 6.50		32.50		Ins. & other items 39.76
	1 Hr. Compressor @ 3.00		3.00		Hough Loader 38.00
	1 hrs. trucking @.75		3.00		Northwest Shovel 57.50
			207.48		Trucking 32.00
1/27/58	Abated 2 Hrs Shovel @ 6.50		13.00		224.59
			# 194.48		
	Labor				
				Bill sent 10-30-57	
				\$ 57.48	
				Corrected bill sent 1-30-58 #44.48	

TOWN OF LEXINGTON—DEPT. OF PUBLIC WORKS

SEWER DIVISION

DATE

NO.

The undersigned applies for the construction of a particular sewer connecting No.
Street and hereby agrees to comply with the Rules and Regulations governing the construction and use of Particular
Sewers, as now or at any future time established by the Board of Selectmen.


Am't of estimate \$.....

Am't Paid \$.....

..... Owner

Sketch of Service Here

21

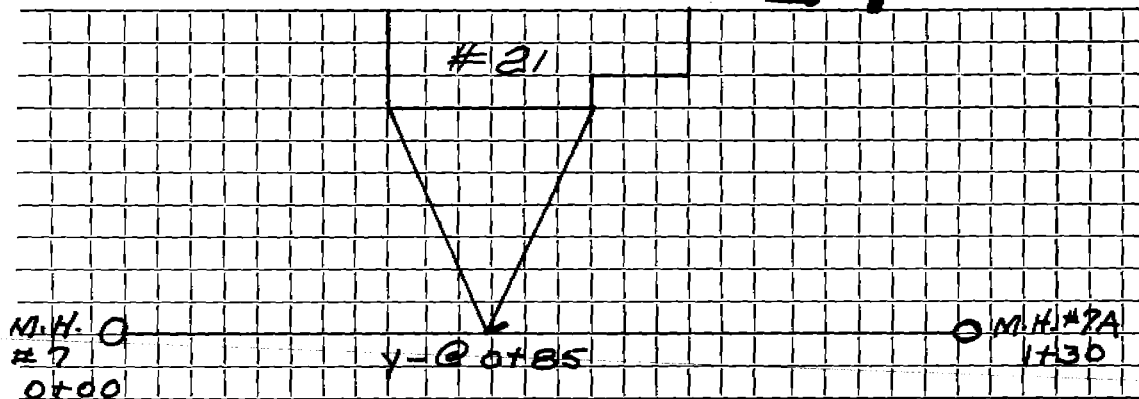

Connection made in Street.

Work completed 19..

Remarks: