


DATE _____

TOWN OF LEXINGTON — BOARD OF PUBLIC WORKS
SEWER DIVISION

Sketch of Service Here
LOT # 8 USE # 23

23

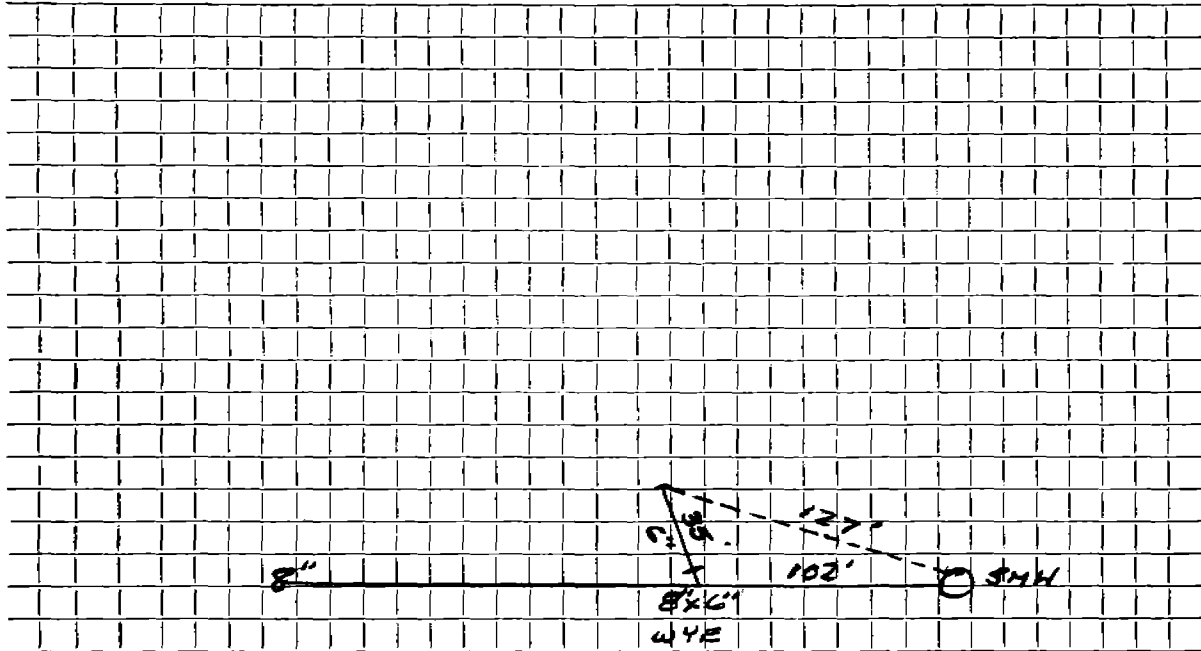

Connection made in BATTLE GREEN RD. Street. Work completed

Remarks:
.....
.....