




DATE \_\_\_\_\_

TOWN OF LEXINGTON — BOARD OF PUBLIC WORKS

SEWER DIVISION

LOT #2 HSE #24

Sketch of Service Here **24**

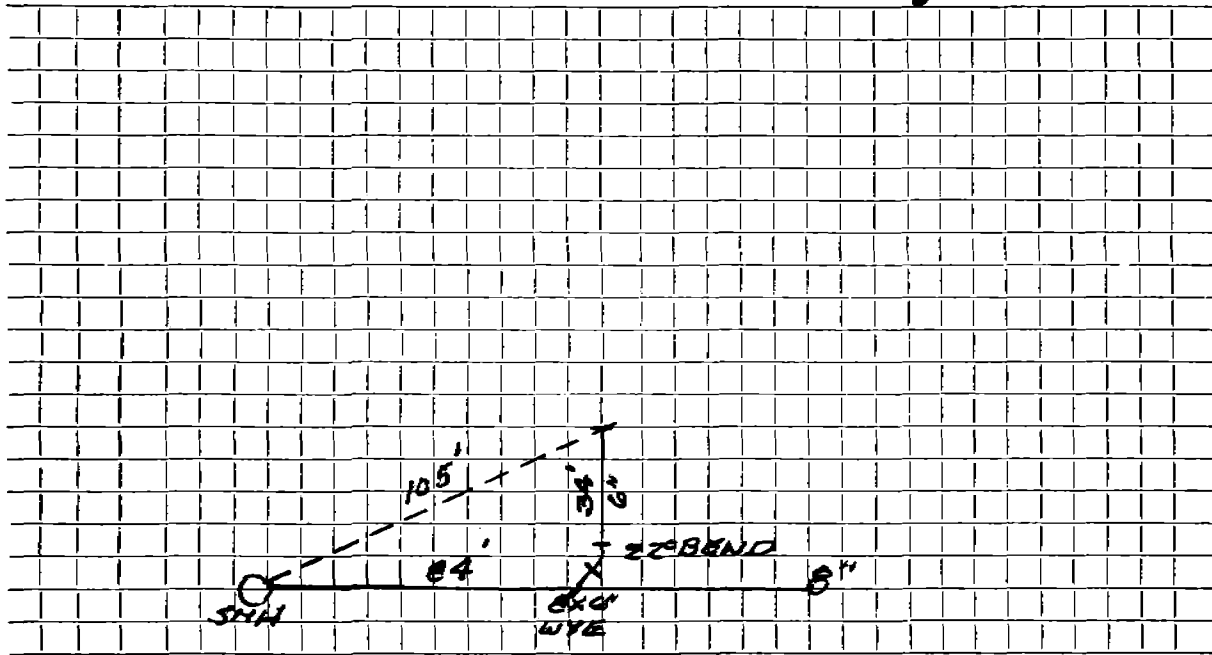

Connection made in BATTLE GREEN RD. Street. Work completed .....

Remarks: .....  
.....  
.....