


DATE _____

TOWN OF LEXINGTON — BOARD OF PUBLIC WORKS
SEWER DIVISION

Sketch of Service Here **29**

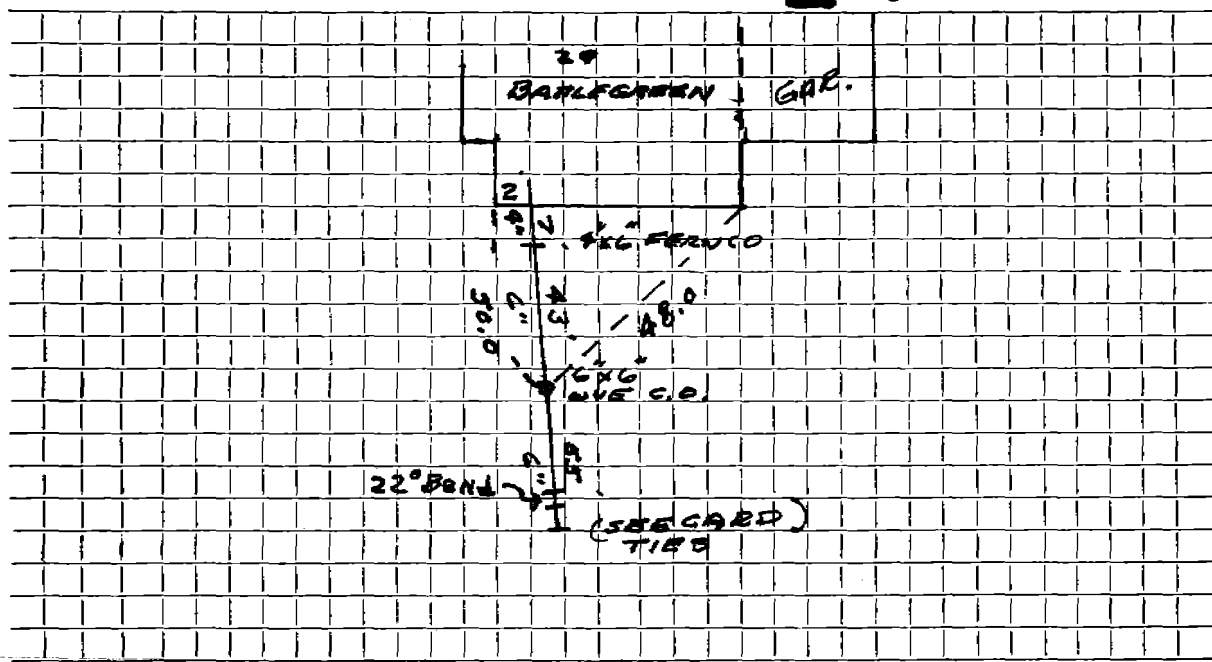

Connection made in BATTLEGREEN RD. Street. Work completed

Remarks: SUB-DIV.

.....
.....