

Name

Service No.

Address

5 BATTLE GREEN

Location

Kind of Pipe

SDR 35

Size

6" PVC

Size of Main

Repair

~~Renewal~~

New Service

Location

Date

Material

Amount

Total

Date

Amount

5/2018 - 6" SDR


- 6" CLEAN OUT
- 6" SDR RISER
- 6" PVC CAP
- 6" TEE WYE

- 45° PVC BEND

DATE 6/2018

TOWN OF LEXINGTON — BOARD OF PUBLIC WORKS
SEWER DIVISION

Sketch of Service Here

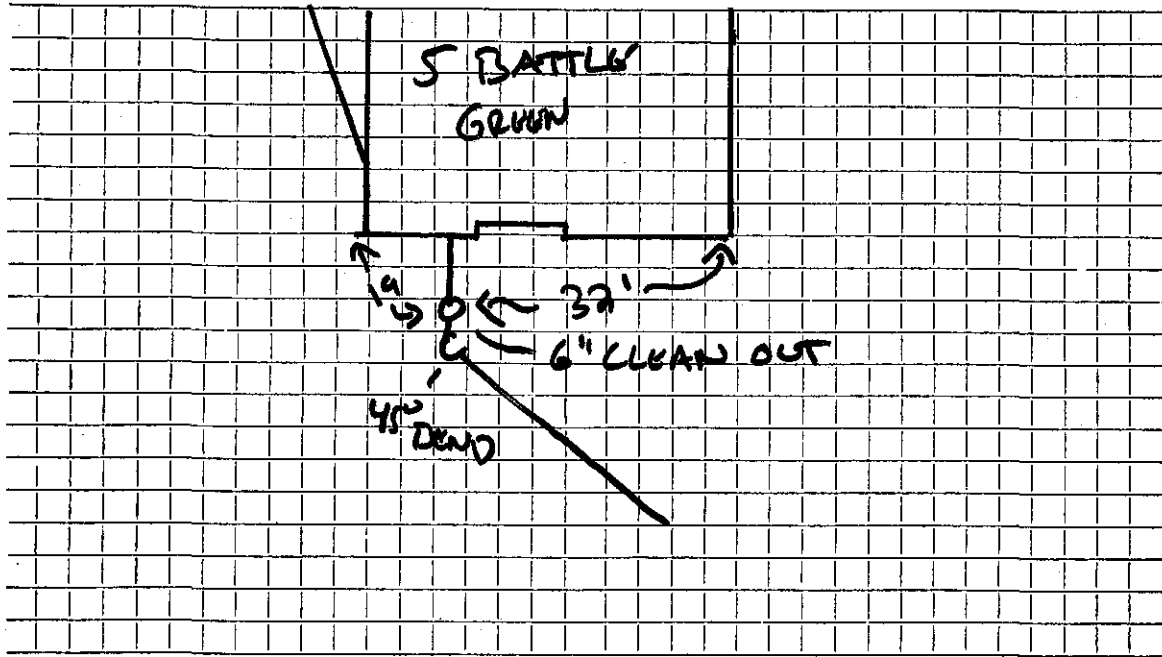

Connection made in DATTLE GREEN Street.

Work completed BOLAND CONTRACTING

Remarks:

.....

.....