

Name Clarence W. Johnson

Service No. 125

Address 9 BATTLEGREEN RD.

Location

Comm. 10-28-57

Kind of Pipe

Size

Size of Main

~~Repair/Replacement~~ New Service

Location

Date	Material	Amount	Total	Date		Amount
8-23-57	Labor	12.38		8-16-57	Deposit	# 150.00
	10% O.H.	4.24	16.62	10-28-57	Refund	30.68
	40' 6" Transite pipe @ .70		28.00			# 119.32
	2 11 1/2" Transite bends @ 5.10		10.20			
	1 1/2 x 3 Patch		14.00			
	2 hrs Town Shovel @ 6.50		13.00			
	2 hrs Trucking @ .75		1.50			
	1 hr. Trucking @ 3.00		3.00			
	1 hr. Rogers Trailer @ 3.00		3.00			
			<u>119.32</u>			
	Labor					

# TOWN OF LEXINGTON—DEPT. OF PUBLIC WORKS

## SEWER DIVISION

DATE .....

NO. ....

The undersigned applies for the construction of a particular sewer connecting No. .... Street and hereby agrees to comply with the Rules and Regulations governing the construction and use of Particular Sewers, as now or at any future time established by the Board of Selectmen.


Am't of estimate \$.....

Am't Paid \$.....

..... Owner

Sketch of Service Here

9

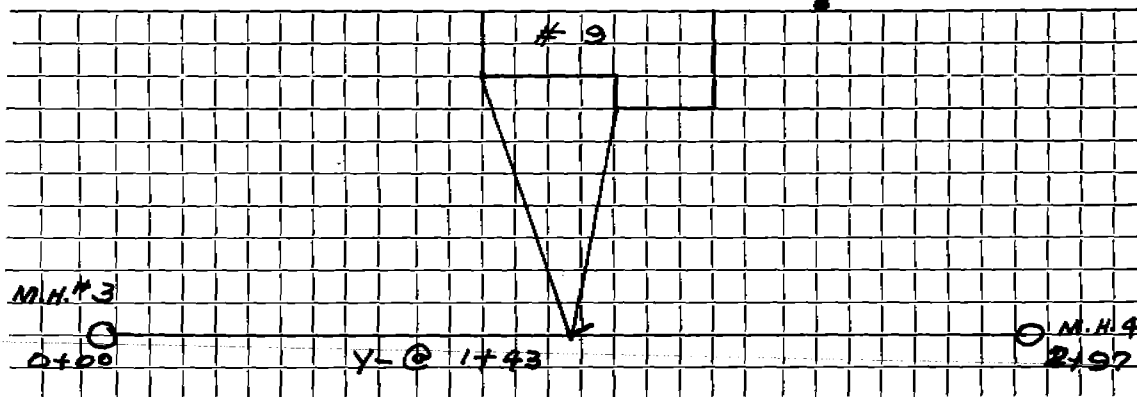

Connection made in ..... Street.

Work completed ..... 19..

Remarks: