


DATE 10-8-82

TOWN OF LEXINGTON — BOARD OF PUBLIC WORKS
SEWER DIVISION

Sketch of Service Here

2

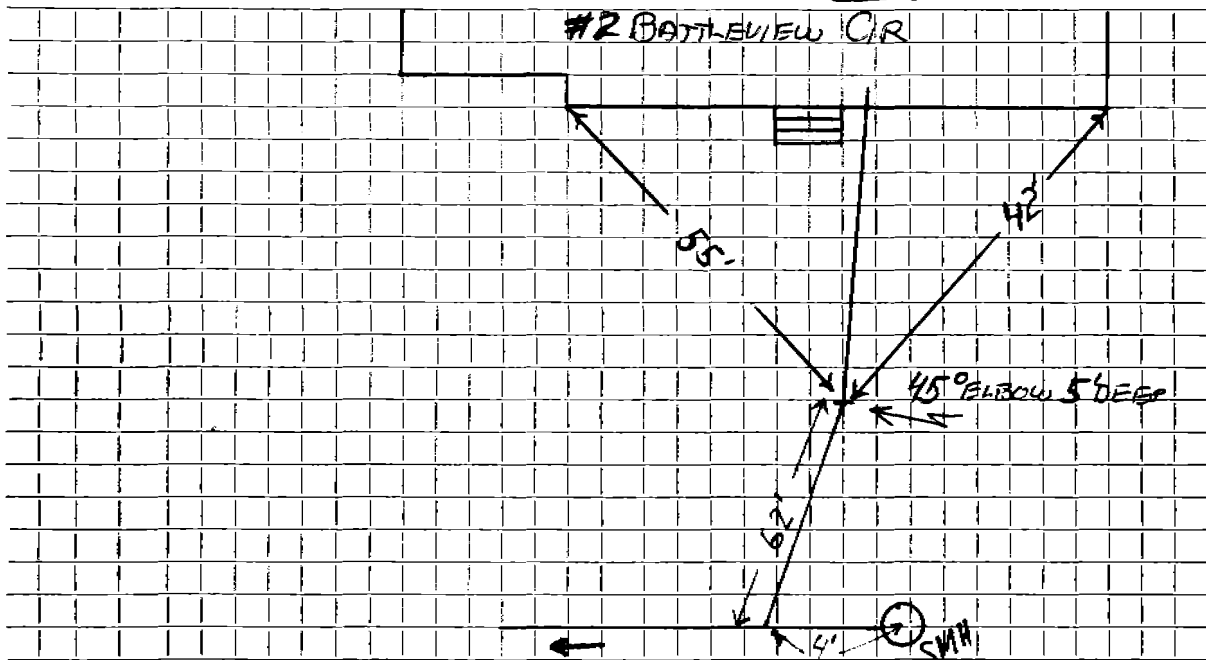

Connection made in BATTLEVIEW CIR Street. Work completed

Remarks: TEE "WYE" FOUR FEET DOWN FROM SMH