




DATE 10-8-82

TOWN OF LEXINGTON — BOARD OF PUBLIC WORKS  
SEWER DIVISION

Sketch of Service Here

3

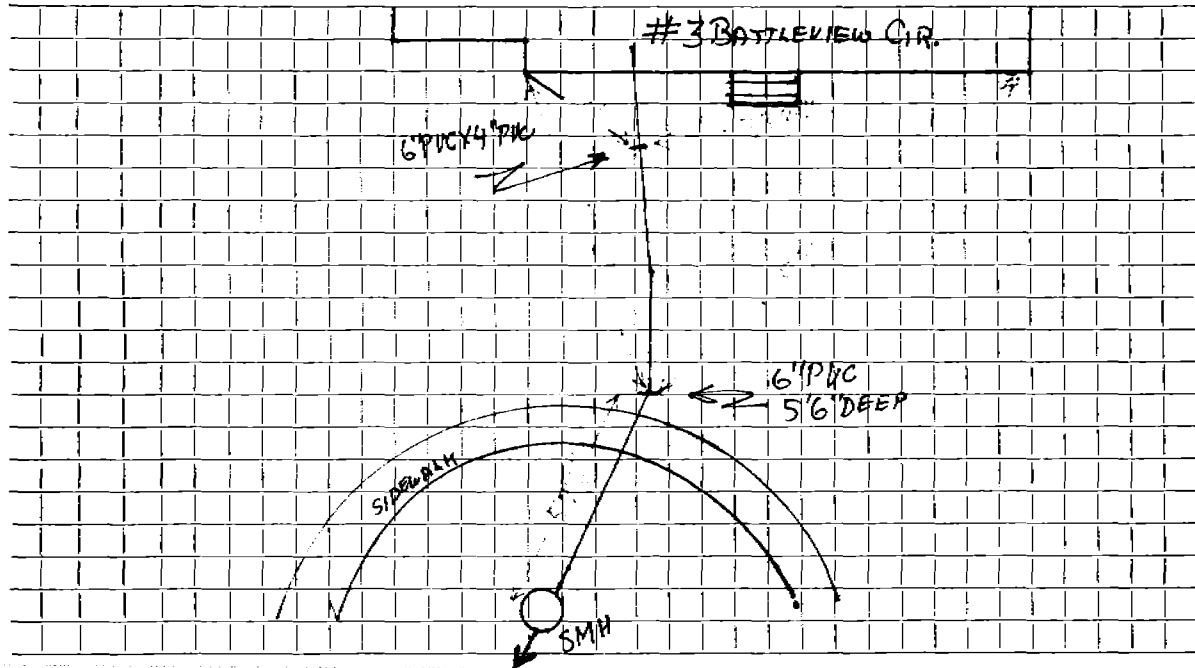

Connection made in BATTLEVIEW CIR Street. Work completed 10-8-82

Remarks: .....

.....

.....