
Name Lex. Historial Society					Service No.			
Name Lex. Historial Society Service No. Address Bedford Street								
				Location				
Kind of Pipe			Size		Size of Main			
Repair—Re	newal—New Service				Location			
Date	Material	Amount	Total	Date	Amount			
			š					
		<u> </u>	1					

UΑ	TE_	 	 	

TOWN OF LEXINGTON - BOARD OF PUBLIC WORKS

SEWER DIVISION

Sketch of Service Here

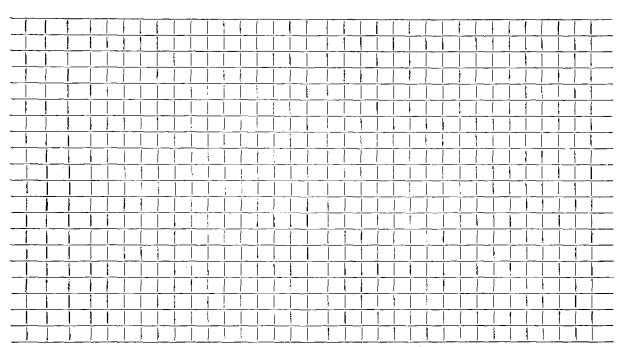

Connection made in			
Remarks: Oxig.in.a.lSex.V	1ce 19	229	