

Name Buckman Tavern

Service No.

Address 1 Bedford Street

Location

Kind of Pipe

Size

Size of Main

~~Repair~~ Renewal ~~New Sewer~~

W.O. #1892.

Location

Date	Material	Amount	Total	Date	Amount
	<u>NON-CHARGE</u>				
3-20-74	Labor	\$ 54.30			
3-21-74	"	144.80			
4-1-74	"	81.78	\$280.88		
	10' 4" Transite Pipe				
	1 5" Transite Elbow				
	4 1 1/2" P.U.C. Pipe				
	3 1 1/2" P.U. C. Cuppling				
	4 1 1/2" P.U.C. Adapter				
	120' 3/4" Copper Pipe				
	1 3/4" Union				
	1 3/4" Wheel Valve				
	6 Hrs. Trucking @3.00		18.00		
	6 Hrs. Town Shovel @6.50		39.00	5-2-78	Roots 81 to 85 1047

DATE _____

TOWN OF LEXINGTON — BOARD OF PUBLIC WORKS

SEWER DIVISION

Sketch of Service Here

A large grid of graph paper, consisting of 20 columns and 20 rows of small squares, intended for sketching service details.

Connection made in Street. Work completed

Remarks:

.....
.....

Name - Buckman Tavern

Service No.

Address 1 Bedford Street

Lexington

Location

Kind of Pipe

Size

Size of Main

Repair—~~RENEW~~ ~~NEW~~ ~~SERVICE~~ ~~XXX~~

Location

Date	Material	Amount	Total	Date	Description	Amount
					<u>NON CHARGE</u>	
				9/22/52	Labor	15 95
				9/23/52	"	21 36
				12ft.	6" sewer pipe @ .342	4 10
					joint compound	72
					2 hrs. trucking	1 50
						43 63
	Labor					

TOWN OF LEXINGTON—DEPT. OF PUBLIC WORKS

SEWER DIVISION

DATE.....

NO.


The undersigned applies for the construction of a particular sewer connecting No.....
 Street and hereby agrees to comply with the Rules and Regulations governing the construction and use of Particular
 Sewers, as now or at any future time established by the Board of Selectmen.

Am't of estimate \$.....

Am't Paid \$.....

..... Owner

Sketch of Service Here

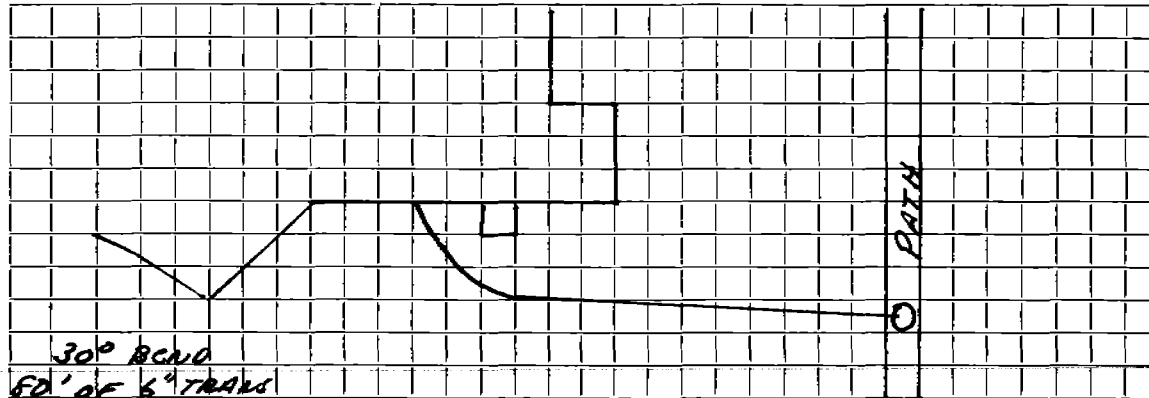

Connection made in Street.

Work completed.....19..

Remarks: