

Name

Service No. 40

Address 10 Bedford St.

Location 10 Bedford Street

Kind of Pipe

Size

Size of Main

Repair—Renewal—New Service

Location

Date

Material

Amount

Total

Date

Amount

Repair Service in Sidewalk W.O. 1467

11/25/80

Labor

- 1 6" x 10' Transite pipe
- 2 6" Fenco Couplings
- 4 ton Gravel
- 1 hr. Trucking - pick up
- 2 hrs. Trucking - Mack
- 4 hrs. Town Shovel

Labor

5/15/70

Stopped up with debris

25 98

Roots 35' out

11-4-80

Roots 30' out

11-2-80

REPAIR 20' out

TOWN OF LEXINGTON—BOARD OF PUBLIC WORKS  
SEWER DIVISION

DATE \_\_\_\_\_

NO. \_\_\_\_\_

The undersigned applies for the construction of a particular sewer connecting No. 10 Bedford St.  
Street and hereby agrees to comply with the Rules and Regulations governing the construction and use of Particular  
Sewers, as now or at any future time established by the Board of Selectmen.


Am't. of Estimate \$ \_\_\_\_\_

Am't. Paid \$ \_\_\_\_\_

\_\_\_\_\_ Owner

Sketch of Service Here

**10**

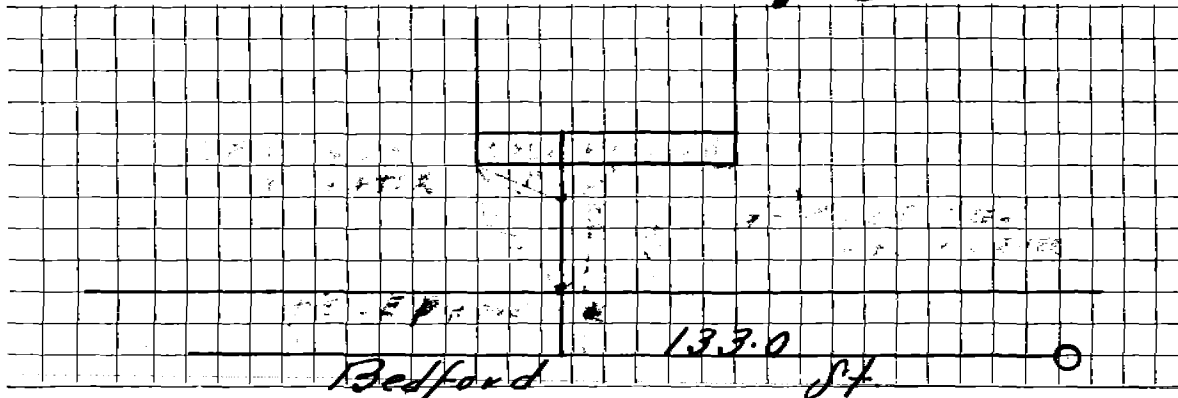

Connection made in \_\_\_\_\_ Street.

Work completed \_\_\_\_\_ 19

Remarks: