

Name Mr. T.A. Custance
 Address ¹⁰⁰
~~70~~ Bedford Street

Service No. 15 23

Location

Kind of Pipe

Size

Size of Main

~~Repair~~ ~~Renewal~~ New Service

Location

Date	Material	Amount	Total	Date	Amount
9/20/33	45' 6" S. Pipe @ .15	6 75			
Com. 43.90	2 6" 1/8" Bends @ .70	1 40		Oct 1 1933 - Cash	43 90
11-21-33	Sulphur & Jute Trucking	1 71 <u>75</u>	10 61		
	55 1/2 Hrs. Labor @ .50	27 75			
	2 " " @ .60	<u>1 20</u>	28 95		
	15% Overhead		<u>4 34</u>		
			43 90	1/24/90 Respond + Measure	
				12/31/92 Respond + measure	
				6/29/96 PAPER BY HAND	
				12-27-65 ROOTS	
				12-4-69	
				8-25-69 PAPER	
	Labor				
	6-8 ALPINE BY ACCOUNT				
	UNDER SIDEWALK				

Hadley Press, Inc., Lexington

TOWN OF LEXINGTON — BOARD OF PUBLIC WORKS
SEWER DIVISION

DATE _____

NO. _____


The undersigned applies for the construction of a particular sewer connecting No. 70 Bedford St.
Street and hereby agrees to comply with the Rules and Regulations governing the construction and use of Particular
Sewers, as now or at any future time established by the Board of Selectmen.

Am't. of Estimate \$ _____

Am't. Paid \$ _____

Theodore A. Custard Owner

Sketch of Service Here

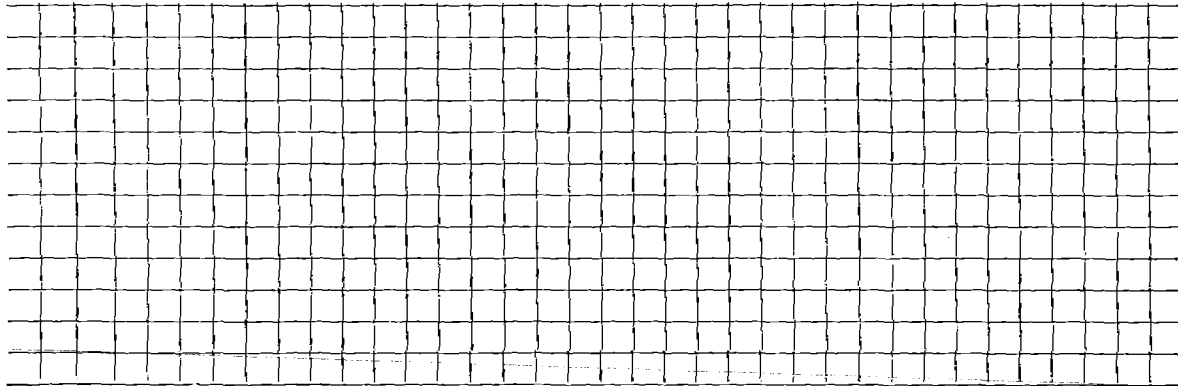

Connection made in _____ Street.

Work completed _____ 19

Remarks: