




DATE 3/30/20

TOWN OF LEXINGTON — BOARD OF PUBLIC WORKS  
SEWER DIVISION

Sketch of Service Here

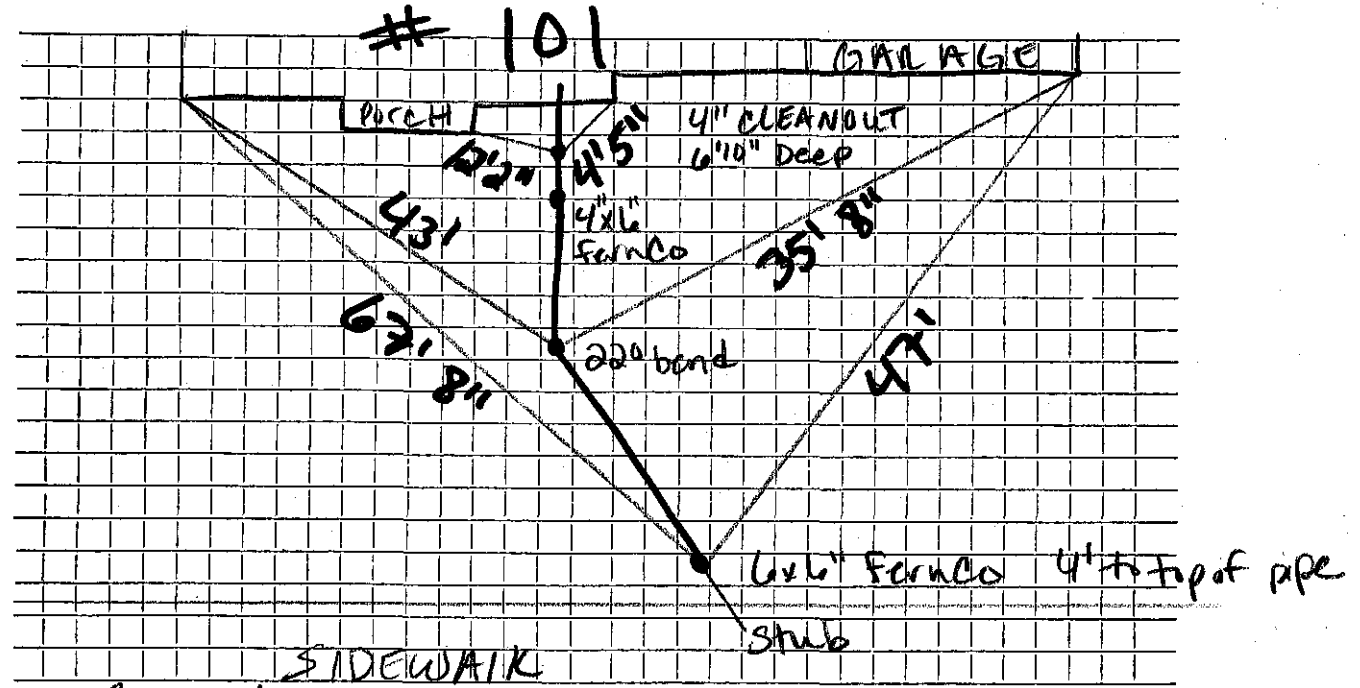

Connection made in Bedford Street. Work completed .....

Remarks: Inspection done through VPA due to Covid-19.

2% slope over 42' run.