

Name Mark Moore

Service No. 58

Address 113 Bedford Street

Location

Kind of Pipe

Size

Size of Main

Repair—Renewal—New Service DeFlice #1401 W.O.#6539

Location **SEP 2 1969**


Date	Material	Amount	Total	Date	Amount
7-8-69	Labor	96.92		6-20-69	340 00
	10% C.H.	9.69	106.61	9-3-69	172 33
	30' 6" Transite pipe @.88		26.40		167 67
	2 6" Couplings @1.09		2.18		
	1 90° Elbow		4.09		
	1 12" Nipple		1.21		
	1 6" Plug		1.93		
	1/2 ton Cold Patch @5.50		2.75		
	2 hr. Shovel @6.50		13.00		
	1 hr. Trucking		3.00		
	1 hr. Trucking		1.50		
	1 hr. Compressor		5.00		
			167.67		
7-10-69	37' 6" Transite pipe				
	10' 4" Cast Iron pipe				

** Apply 57.19 to W.O.# 26*

DATE _____

TOWN OF LEXINGTON — BOARD OF PUBLIC WORKS
SEWER DIVISION

Sketch of Service Here **113**

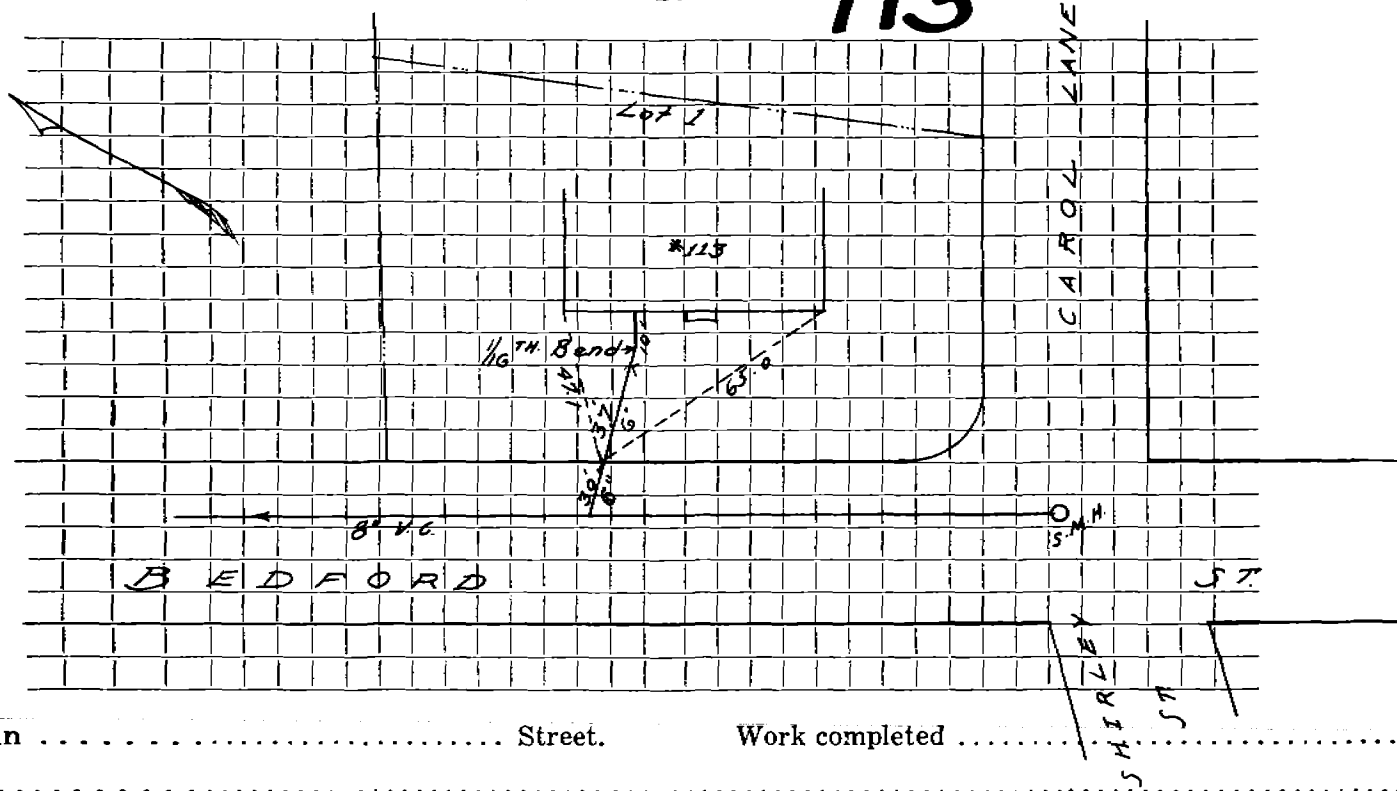

Connection made in Street. Work completed

Remarks:
.....
.....