

Name Louis Esposito

Service No. 175 (1956)

Address 116 Bedford Street

Location

Comm. 3/18/57

Kind of Pipe

Size

Size of Main

~~Repair~~ ~~Renewal~~ - New Service

Location

Date	Material	Amount	Total	Date		Amount
12-5-56	Labor	70.20		11-20-56	Deposit	\$ 200.00
	10% O.H.	7.02	77.22	3-18-57	Refund	46.49
	55'6" Sewer pipe @.435		23.93			\$ 153.51
	Joint Compound		3.36		NON CHARGE	
	5 hrs. Town Shovel @ 6.50	6.50	32.50	12-6-56	Labor	74.10
	2 hrs Trucking @.75		1.50		@ 6.50	26.00
	15 x 3 Patching		15.00		2 hrs Truck @.75	1.50
			153.51			101.60
	Labor					

TOWN OF LEXINGTON—DEPT. OF PUBLIC WORKS
SEWER DIVISION

DATE

NO.

The undersigned applies for the construction of a particular sewer connecting No.
Street and hereby agrees to comply with the Rules and Regulations governing the construction and use of Particular
Sewers, as now or at any future time established by the Board of Selectmen.


Am't of estimate \$.....

Am't Paid \$.....

..... Owner

Sketch of Service Here

116

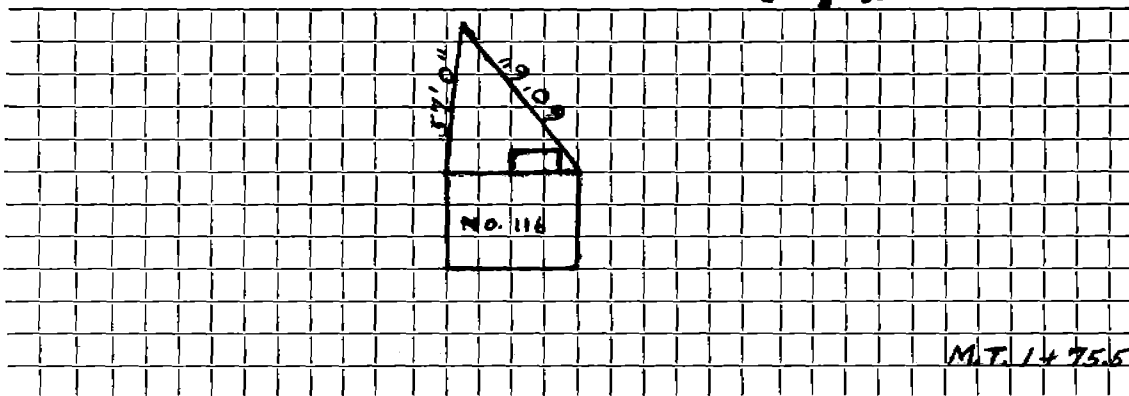

M.T. 1475.5

Connection made in Street.


Work completed 19..

Remarks:

DATE _____

TOWN OF LEXINGTON — BOARD OF PUBLIC WORKS
SEWER DIVISION

Sketch of Service Here

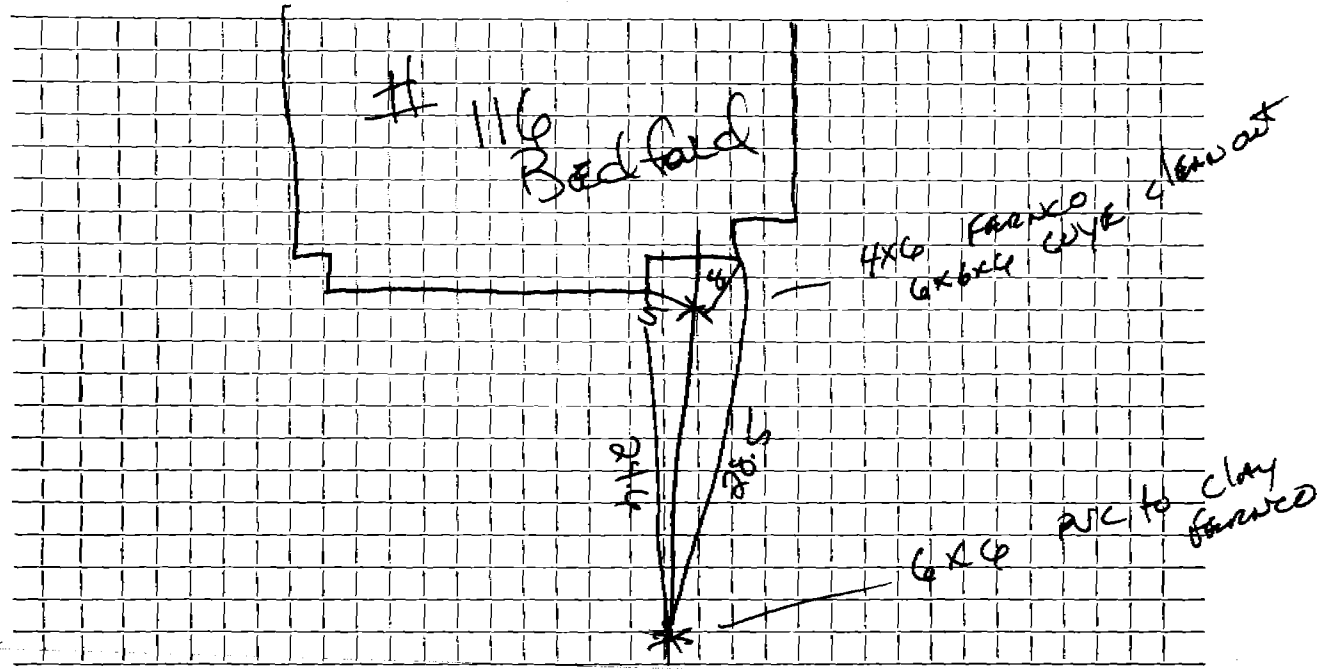

Connection made in Street. Work completed

Remarks:
.....
.....