

Name

Service No.

Address 117 BEDFORD ST.

Location

Kind of Pipe

Size

Size of Main

Repair—Renewal—New Service

Location

Date

Material

Amount

Total

Date

Amount

DISCONTINUED

Labor

TOWN OF LEXINGTON—DEPT. OF PUBLIC WORKS  
SEWER DIVISION

DATE .....

NO. ....

The undersigned applies for the construction of a particular sewer connecting No. ....  
Street and hereby agrees to comply with the Rules and Regulations governing the construction and use of Particular  
Sewers, as now or at any future time established by the Board of Selectmen.

Am't of estimate \$.....


Am't Paid \$.....

..... Owner

117

Sketch of Service Here

FOR # 117

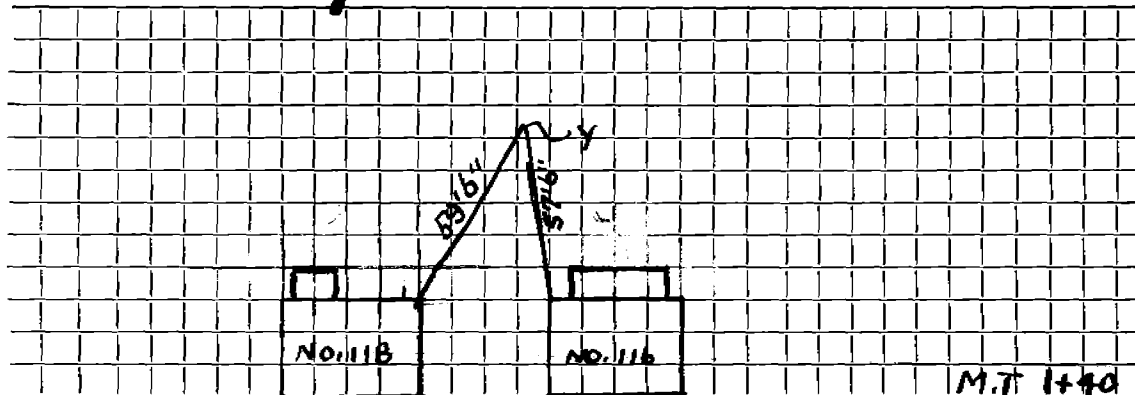

Connection made in ..... Street.

Work completed ..... 19..

Remarks: