

Name

Service No.

Address 118 BEDFORD ST.

Location

Kind of Pipe

Size

Size of Main

Repair—Renewal—New Service

Location

| Date | Material | Amount | Total | Date | Amount |
|------|----------|--------|-------|------|--------|
|------|----------|--------|-------|------|--------|

7-9-57

71/6" Transite

Labor

TOWN OF LEXINGTON—DEPT. OF PUBLIC WORKS

SEWER DIVISION

DATE

NO.

The undersigned applies for the construction of a particular sewer connecting No.
Street and hereby agrees to comply with the Rules and Regulations governing the construction and use of Particular
Sewers, as now or at any future time established by the Board of Selectmen.


Am't of estimate \$.....

Am't Paid \$.....

..... Owner

Sketch of Service Here

118

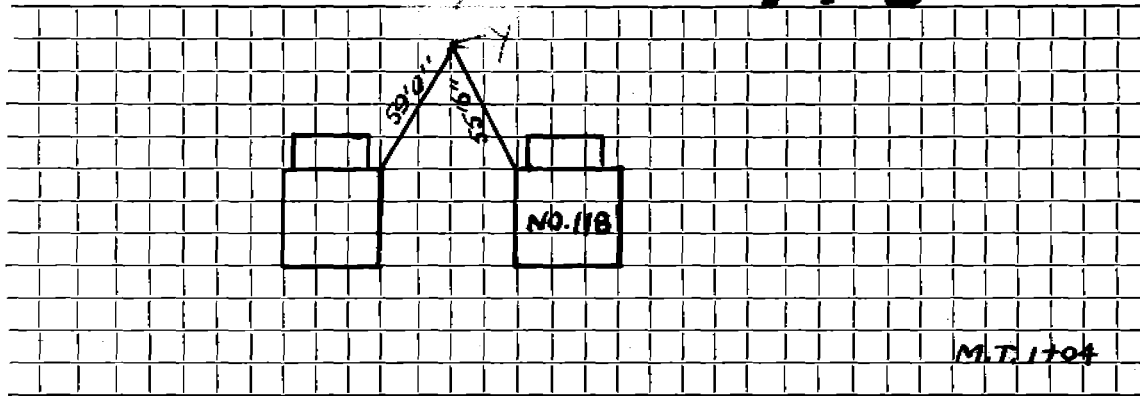

Connection made in Street.

Work completed 19..

Remarks: