

Name William F. McBride

Service No. 7

Address 121 Bedford Street

Location

Kind of Pipe

Size

Size of Main

Repair—Renewal—New Service Valeri #967 W.O.#6372


Location Aug 5, 1968

Date	Material	Amount	Total	Date	Amount
4-9-68	Labor 108.90			3-27-68	275.60
4-12-68	" 12.50			8-5-68	38.20
4-12-68	" 16.18	137.58			236.73
	10% O.H.	13.76	151.34		
	20' 6" Transite @.88		17.60		
	1 6 x 10 Saddle		5.50		
	1 90° Elbow		4.09		
	1½ ton Hot Top @5.80		8.70		
	5 hr. Trucking @3.00		15.00		
	4 hrs. Shovel @6.50		26.00		
	1 hr. Compressor		5.00		
	½ hr. Roller & trailer		3.50		
			236.73		
4-17-68	60' 6" Transite pipe				
	5' 4" Cast Iron Pipe				

DATE _____

TOWN OF LEXINGTON — BOARD OF PUBLIC WORKS
SEWER DIVISION

Sketch of Service Here **121**

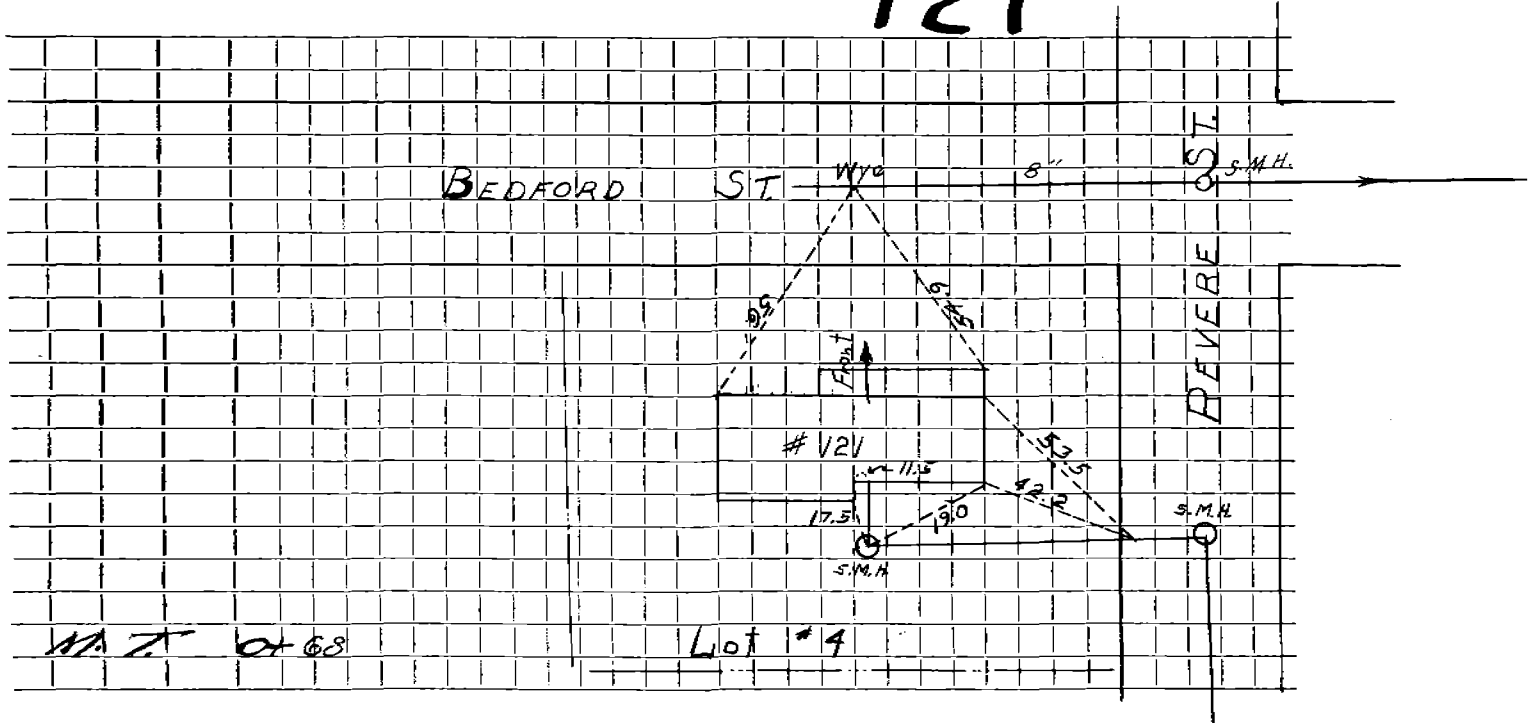

Connection made in Street. Work completed

marks:
.....
.....