

Name Paul G. Cunningham

Service No. 176

Address 133 Bedford Street

Location

Comm. 12-2-57

Kind of Pipe

Size

Size of Main

~~Repair or Renewal~~—New Service

Location

Date	Material	Amount	Total	Date		Amount
10/28/57	labor	66 18		10-1-57	Deposit	\$ 2.50 as
	10% overhead	6 62		12-2-57	Refund	57 90
			72 80			\$ 192 10
10 1/2'	6" transite @ .70		72 80		REPAIR	
4'	6" claypipe @ .435		1 74	11/19/88	10' 6" PVC	
2	6" clay elbows @ 1.88		3 76	1	6" PVC Elbow	
20 x 3	patch		20 00	1	6" AC to PVC Adp .	
3 hrs.	town shovel @ 6.50		19 50	1	6" Clay to PVC Fernco	
2 hrs.	trucking @ .75		1 50	2	6" AC to PVC Fernco	
			192 10	1	6" Wye	
				1	6" 45° Coupling	
				1	6" Cap	
	Labor					

TOWN OF LEXINGTON—DEPT. OF PUBLIC WORKS
SEWER DIVISION

DATE.....

NO.

The undersigned applies for the construction of a particular sewer connecting No.....
Street and hereby agrees to comply with the Rules and Regulations governing the construction and use of Particular
Sewers, as now or at any future time established by the Board of Selectmen.


Am't of estimate \$.....

Am't Paid \$.....

..... Owner

Sketch of Service Here

133

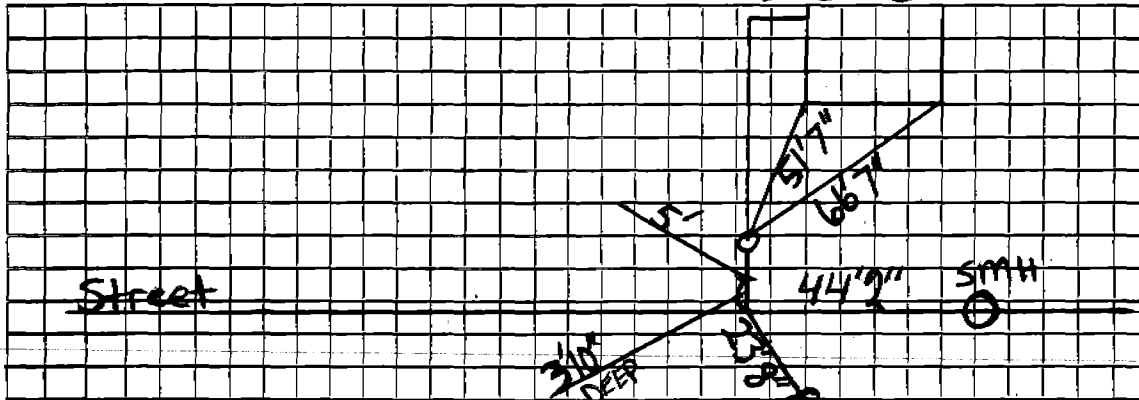

Connection made In..... Street.

Work completed..... 19..

Remarks: