

Name M. Esther Smith

Service No. 68

Address #148 Bedford St.

Location

Kind of Pipe

Size

Size of Main

~~REPAIR~~ New Service

W.C.# 8691

Location Comm 9-21-64

Date	Material	Amount	Total	Date	Amount
6-11-61	Labor 94.91			4-27-64	Deposit 250 00
6-12-61	" 69.34	164 25		11-30-64	Paid 52 56
	10% O.H.	16 43	180 68		302 56
60'	6" Transite pipe @ .82		49 20	8-21-63	
1	Bag Cement		1 50	20'	6" TRANSITE
1	11 1/2° Transite bend		4 09		
1	90° Transite elbow		4 09		
2	Yds Loam		6 00		
1 1/4	X 3 Patch		14 00		
4	Hrs Town Shovel @ 6.50		26 00		
4	Hrs Trucking @ 3.00		12 00		
1	Hr Compressore @ 5.00		5 00		
			302 56		


DATE _____

TOWN OF LEXINGTON — BOARD OF PUBLIC WORKS

SEWER DIVISION

Sketch of Service Here

148

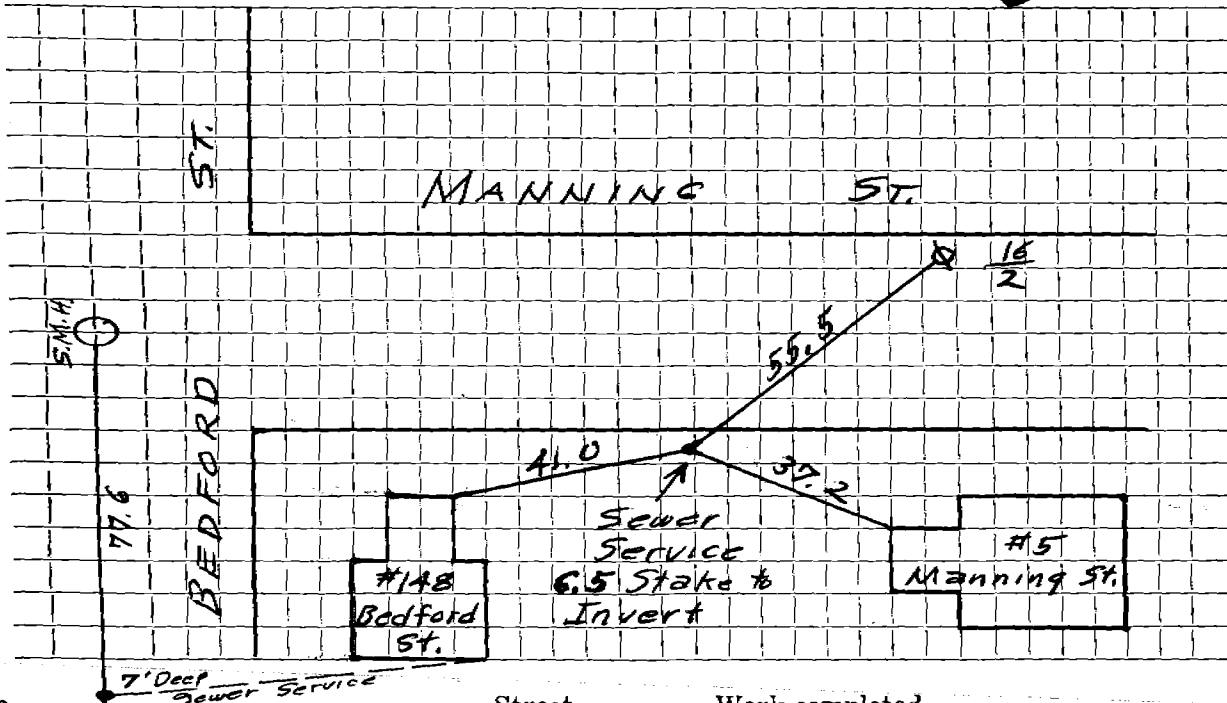

Connection made in Street. Work completed

Remarks:
.....
.....