

Name Henry Johnson

Service No. 4/4/ 11 68

Address 15 Bedford Street

Location 15 Bedford Street

Kind of Pipe

Size

Size of Main

Repair—Renewal—New Service W.C.#6423

Location NOV 18 1968

Hadley Press, Inc., Lexington

Date	Material	Amount	Total	Date	Amount
4/2/68	Labor	17.71		4-2-68	325 00
4/3/68	"	129.72		4-18-6	36 79
4/4/68	"	23.88	171 31		288 21
	10% O.H.	17 13	188 44		
35'	6" Transite Pipe		30 80		
2	22 1/2° Bends		8 18		
1	11 1/4° Bend		4 09		
1	22 1/2° Elbow		2 35		
100	Bricks		4 25		
2	Bags Cement		3 10		
1	Frame & Cover		10 50		
4	Hrs. Trucking		12 00	12-12-67	
	Labor				
3	Hrs. Shovel		19 50		
1	Hr. Roller		3 00		
	Trailer		2 00		
			288 21		

Deposit
Refund

Bricks were
12-12-67

TOWN OF LEXINGTON—BOARD OF PUBLIC WORKS
SEWER DIVISION

DATE _____

NO. _____

The undersigned applies for the construction of a particular sewer connecting No. 15 Bedford St. Street and hereby agrees to comply with the Rules and Regulations governing the construction and use of Particular Sewers, as now or at any future time established by the Board of Selectmen.


Am't. of Estimate \$ _____

Am't. Paid \$ _____

Owner

Sketch of Service Here

15

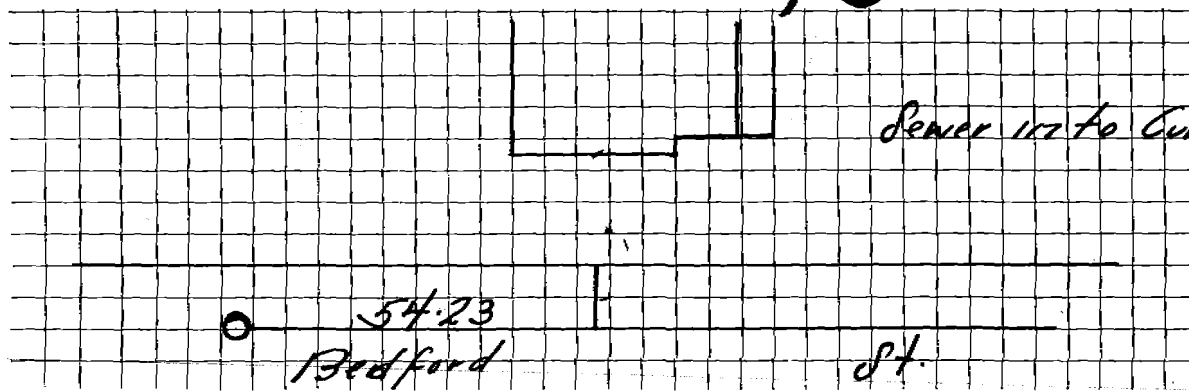

Connection made in _____ Street.

Work completed _____ 19

Remarks: