

Name Frank S. Allia

Service No. 78

Address 154 Bedford Street

Location

Kind of Pipe Transite

Size 6"

Size of Main

~~Repair - Renewal~~ - New Service W.O. #3609 DeFelice Bros. #2909.

Location MAR 15 1976


Date	Material	Amount	Total	Date	Amount
8-15-75	Labor	337.59		8-8-75	475.00
	10% O.H.	33.76	371.35	4-9-76	24.39
2	10' x 6" Transite Pipe @1.48/Ft.		29.60		499.39
1	5' x 6" " " @1.56/Ft.		7.80		
1	2' x 22 $\frac{1}{2}$ " El		3.84		
1	6" Plug		3.75		
$\frac{1}{2}$	Bag Cement		.55		
1	15' x 4" Patch		40.00		
2	Hrs. Trucking @3.00		6.00		
1	Hr. Pickup @1.50		1.50		
1	Hr. Compressor @5.00		5.00		
1	Hr. Loader @4.00		4.00		
4	Hrs. Town Shovel @6.50		26.00		
9-29-75	20' 6" Transite pipe		\$499.39		
	8' 4" C.I. pipe				
					1011 7.5439

DATE _____

TOWN OF LEXINGTON — BOARD OF PUBLIC WORKS
SEWER DIVISION

Sketch of Service Here

154

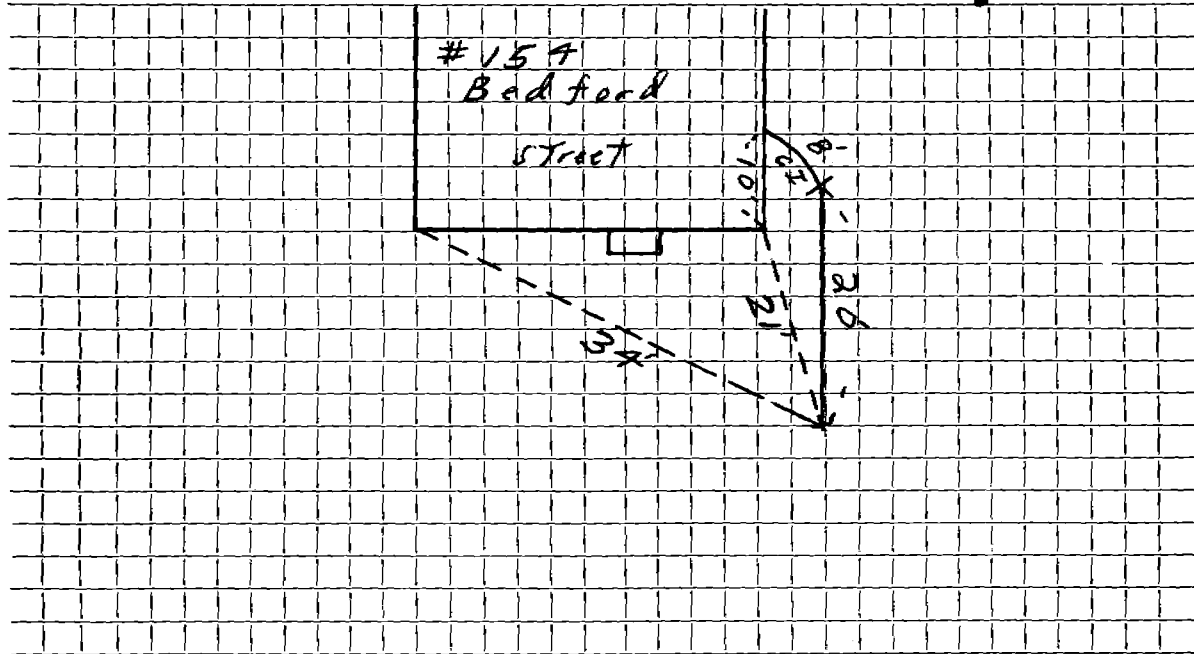

Connection made in Street. Work completed

Remarks:

.....

.....