

Name Moore Realty Trust

Service No. 195

Address 159-161 Bedford Street

Location

Kind of Pipe DeFlice Bros. Permit #188

Size

Size of Main

~~Repair~~ Renewal New Service W.O. #9392

Location

Date	Material	Amount	Total		Date	Amount
12-14-64	Labor	56 92			12-2-64	100 00
	10% O.H.	5 69	62 61	61	3-30-65	24 36
	25' 6" Transite Pipe @.82		20 50	50		124 36
	1 6 X 8 Service Saddle		5 25	25		
	12 X 3 Patch		12 00	00		
	3 Hrs. Shovel @6.50		19 50	50		
	1 1/2 Hrs. Truck @3.00		4 50	50		
			124 36	36		
12-31-64	50' 6" Transite Pipe					

Billed 50' + 24.36


DATE _____

TOWN OF LEXINGTON — BOARD OF PUBLIC WORKS

SEWER DIVISION

Sketch of Service Here

159 + 161

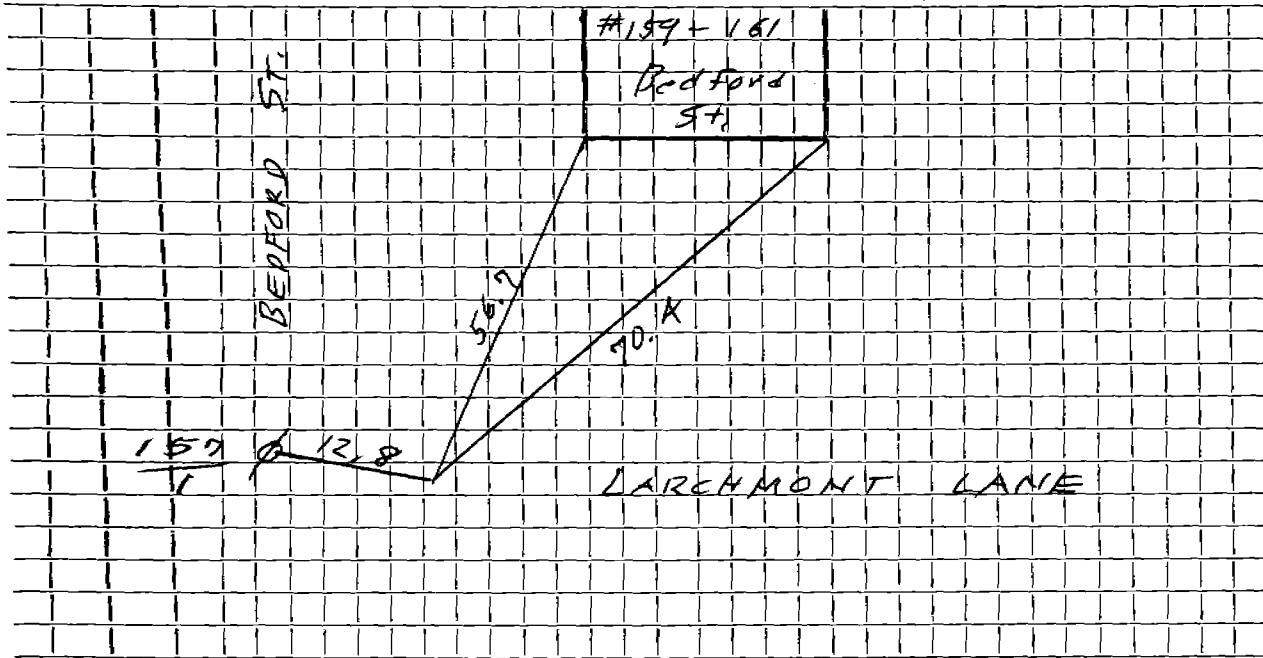

Connection made in Street. Work completed

Remarks:
.....
.....