

Name Liberty Mutual Insurance

Service No.

Address 171 Bedford Street

Location

Kind of Pipe

Size

Size of Main

Repair—Renewal—New Service Marino


Location

Date		Material	Amount		Total		Date		Amount	
9-13-69	549	6" Transite pipe								
	22	4" Cast Iron pipe								


DATE _____

TOWN OF LEXINGTON — BOARD OF PUBLIC WORKS

SEWER DIVISION

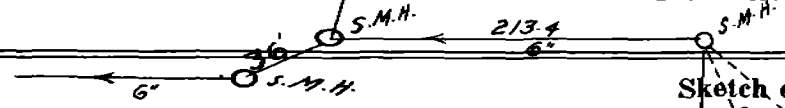

Sketch of Service Here **171**

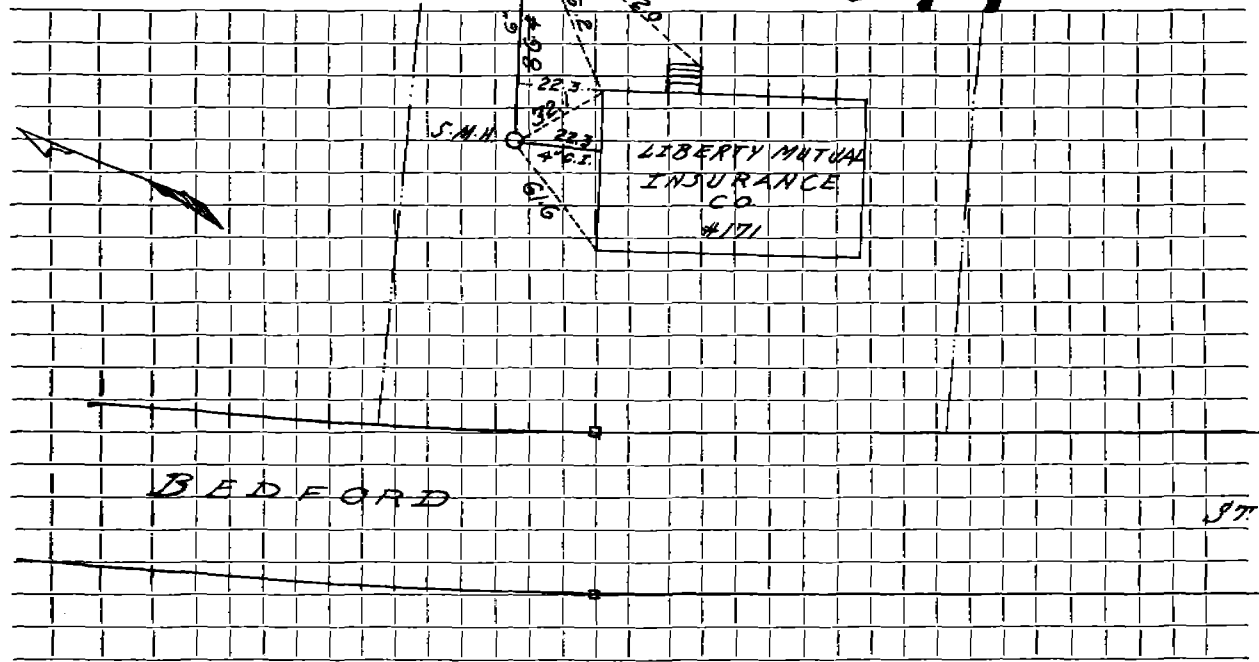

Connection made in Street. Work completed

Remarks:
.....
.....