

Name Outhet Realty Trust

Service No. 181

Address 172 - 184 Bedford Street

## Location

Kind of Pipe

Size

Size of Main

~~RIPROCK~~—New ServiceLocation *Cond 12-12-60*

Date	Material	Amount	Total	Date	Amount
9-21-60	Labor	12.45		9-19-60	600.00
9-22-60	"	59.68		12-12-60*	74.37
9-24-60	"	102.31	174.44		523.63
	10% O.H.	17.44	191.88		
	175' 6" Transite pipe @ .78		136.50		
	1 22½° Transite Elbow		2.24		
	1 22½° Transite Bend		6.21		
	Build on Manhole		27.20		
	105 Sewer Brick @ 4.21 per 100		44.10		
	7 Bags Cement @ 1.50		10.50	6-10-92	OWNER'S RESPONSIBILITY
	3 Tons Sand @ 1.00 ton		3.00		Have him get a plumber
	1 Sewer Manhole Cover & Frame		35.00		
	8 hrs. Town Shovel @ 6.50		52.00		
	5 hrs. Trucking @ 3.00		15.00		
			523.63		

\* Apply (00-41) to MHCT 220


DATE \_\_\_\_\_

TOWN OF LEXINGTON — BOARD OF PUBLIC WORKS

SEWER DIVISION

Sketch of Service Here

172-184 Bedford St

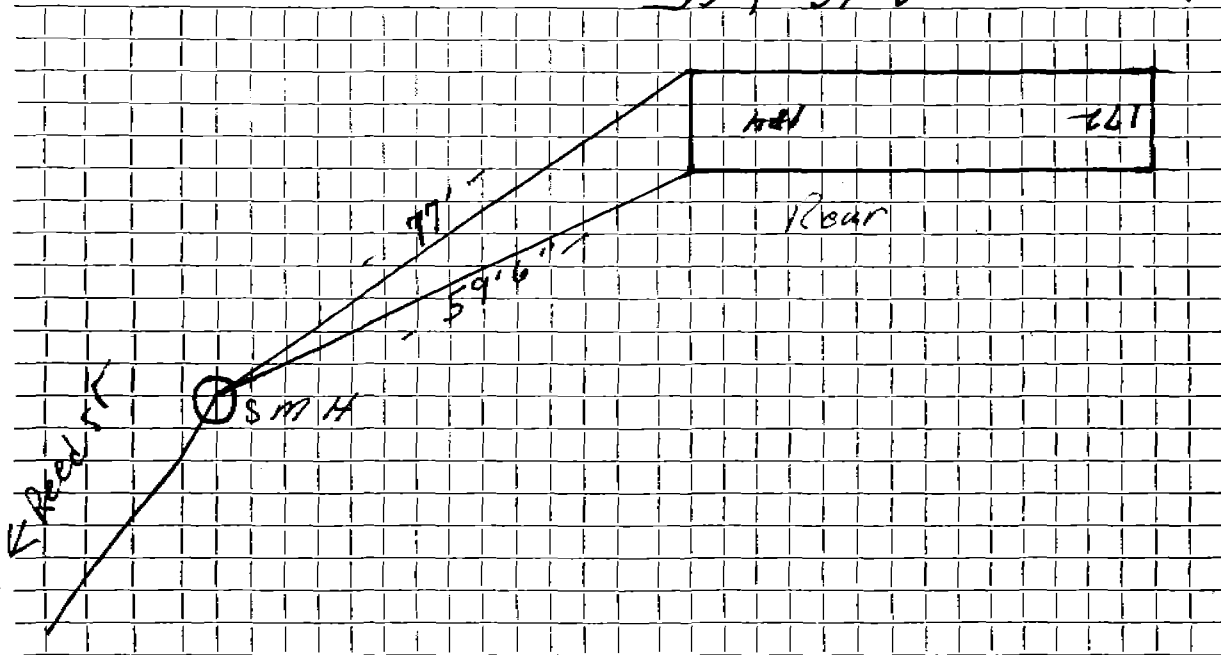

Connection made in ..... Street. Work completed .....

Remarks: .....  
.....  
.....