


DATE 5/6/81

TOWN OF LEXINGTON — BOARD OF PUBLIC WORKS
SEWER DIVISION

Sketch of Service Here

175

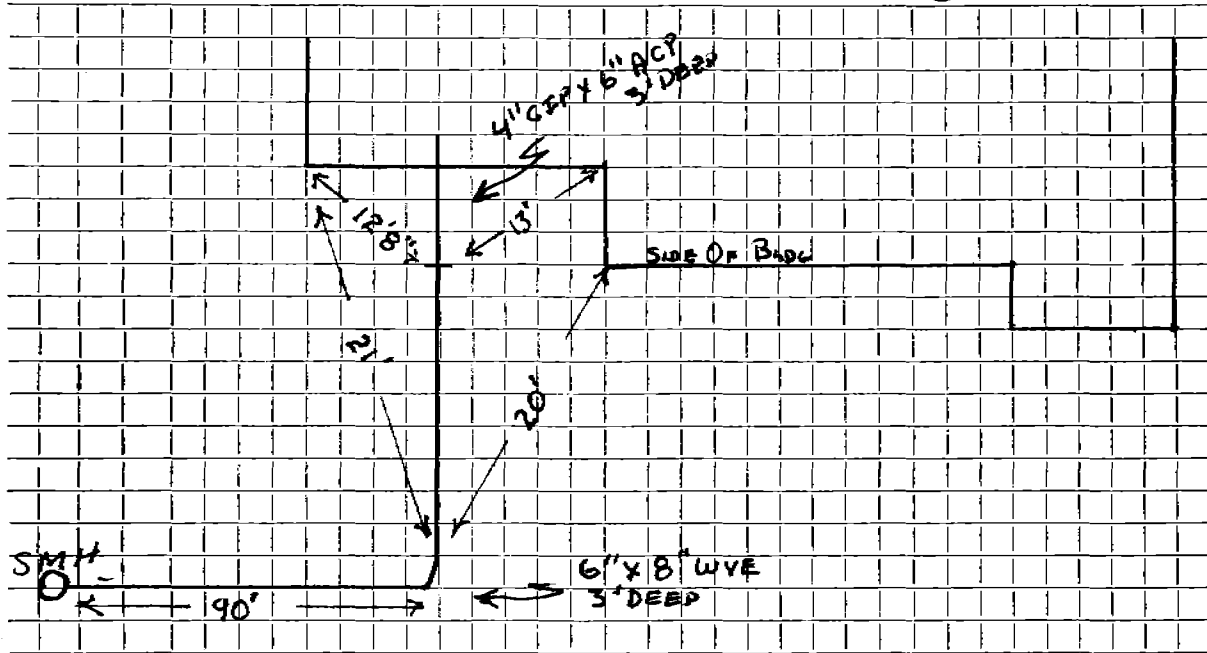

Connection made in EASEMENT BESIDE BLDG. Street. Work completed

Remarks:

.....
.....