

Name Foster & Foster

Service No.

Address 185 Bedford Street

Location

Kind of Pipe

Size

Size of Main

~~Repair/Reconnect~~ New Service DeFlice #3224


Location

Date		Material	Amount	Total	Date		Amount
5-9-78	52'	6" Transite pipe					
	10'	4" Cast iron pipe					

DATE \_\_\_\_\_

TOWN OF LEXINGTON — BOARD OF PUBLIC WORKS  
SEWER DIVISION

Sketch of Service Here **185**

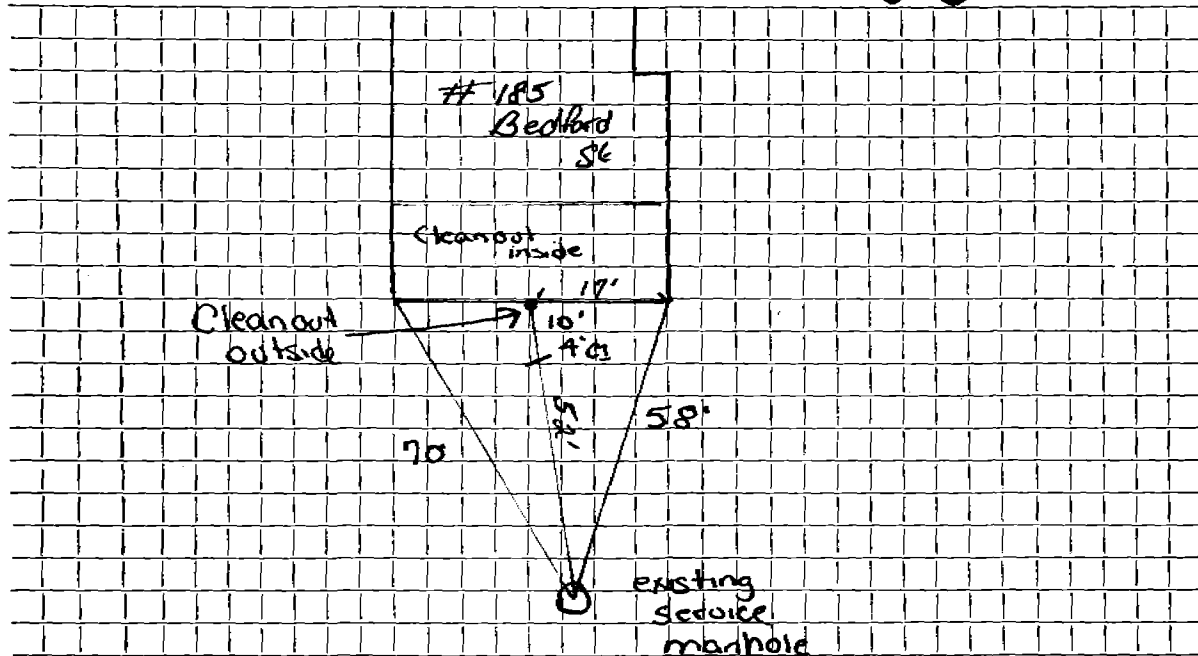

Connection made in ..... Street. Work completed .....

Remarks: .....  
.....  
.....