

Name Arthur Zeitler

Service No.

Address 187 Bedford Street

Location

Kind of Pipe

Size

Size of Main

Repair—Renewal—New Service Eagle #1825

Location


Date		Material	Amount		Total		Date		Amount	
3-31-71	32'	4" Cast Iron pipe								

DATE 6-1-72

TOWN OF LEXINGTON — BOARD OF PUBLIC WORKS
SEWER DIVISION

Sketch of Service Here

187

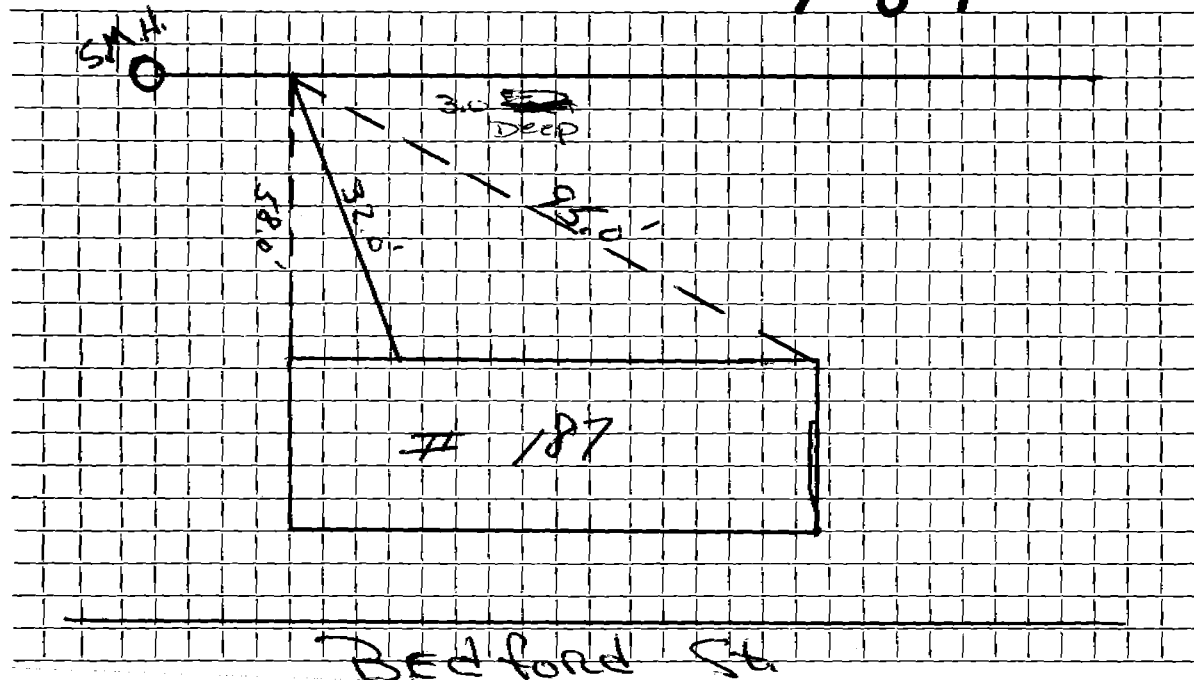

Connection made in Street. Work completed

Remarks:
.....
.....