




DATE 9-12-94

TOWN OF LEXINGTON — BOARD OF PUBLIC WORKS  
SEWER DIVISION

Sketch of Service Here

197-199

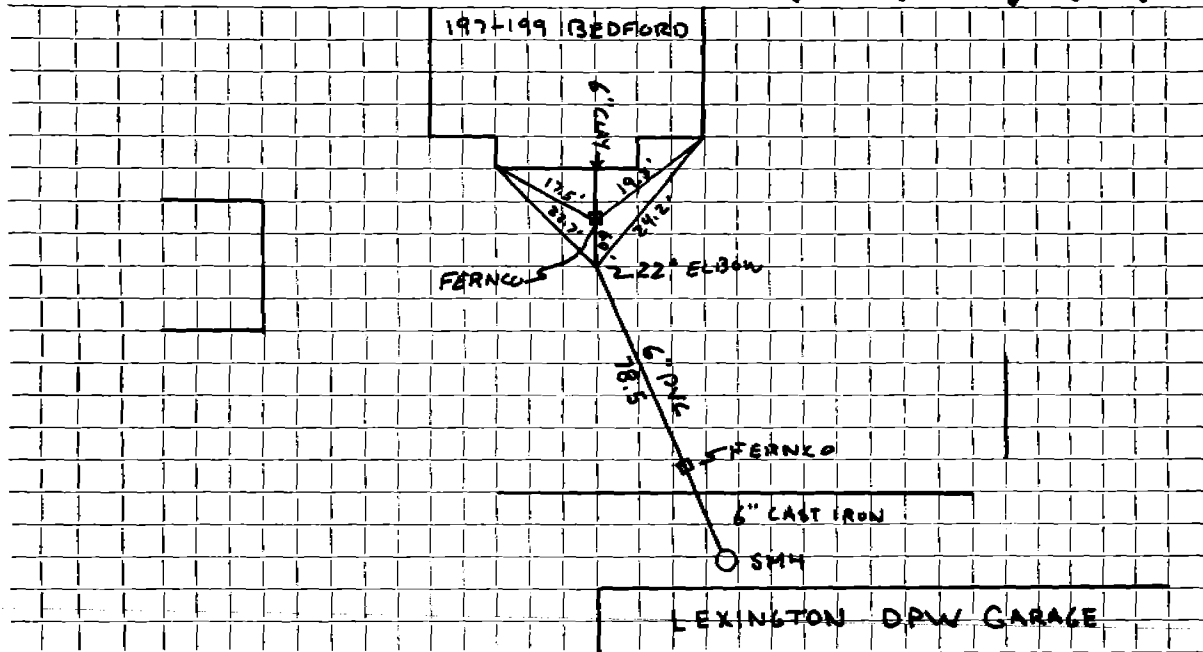

Connection made in DPW YARD Street. Work completed .....

Remarks: .....