

Name

Service No.

Address

Location

Kind of Pipe

Size

Size of Main

Repair—Renewal—New Service


Location

Date	Material	Amount	Total	Date		Amount
------	----------	--------	-------	------	--	--------

DATE \_\_\_\_\_

TOWN OF LEXINGTON — BOARD OF PUBLIC WORKS  
SEWER DIVISION

Sketch of Service Here **200**

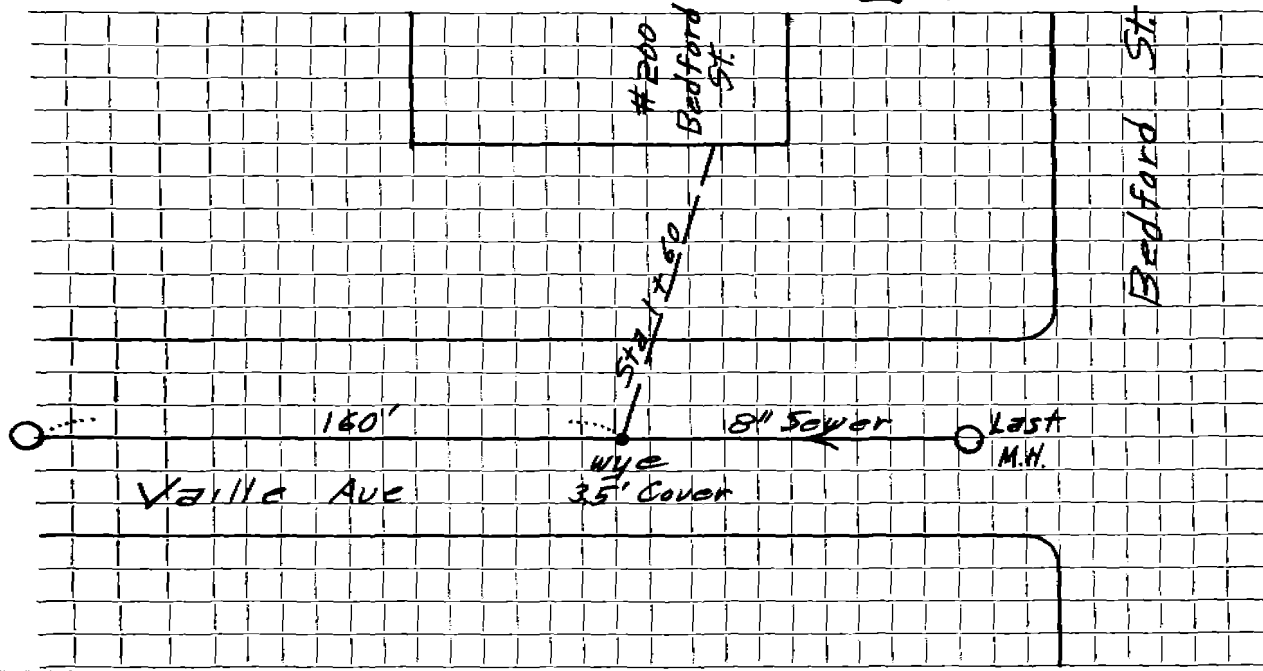

Connection made in ..... Street. Work completed .....

Remarks: .....  
.....  
.....