Address 2	1 Bec	l.ford	LSTre	eT


Kind of Pipe				Size				Size of Main			
Rep	air—R	Renewal—New Service							Location		
Date		Material	Amour	nt	Tota	al .	Date	 •		Amo	unt
1/- 22-	27										
	38	6" Sewer									
				-					•		<u> </u>
							2.271	02	MAIN Black	ed.	<u> </u>
5.25.0	0	Rappin made putting in wat	by con	HEAC	for				Flushed freom 7	Behind	
	<u> </u>	putting in wat	er skr	Vic	<u></u>				Buchman Toweld	· MH	ie
	<u> </u>								ON Stone dust	PALL	<u> </u>
		2- 6x6 Clay to	BUC F	een	203			ļ			
		3'- 6" 7VC	Pipe	ļ				<u> </u>			
								ļ			
				ļ							
	<u> </u>			<b></b>		<del> </del>		<u> </u>			<b>\</b>
	ļ			ļ				ļ			<del> </del>
	<u> </u>			ļ		<del>                                     </del>					
				<u> </u>				ļ		<del> </del>	<del> </del>
	!						j			1	

Location

~ *	TE	•			
_,_			 _	 _	

## TOWN OF LEXINGTON — BOARD OF PUBLIC WORKS SEWER DIVISION

## Sketch of Service Here

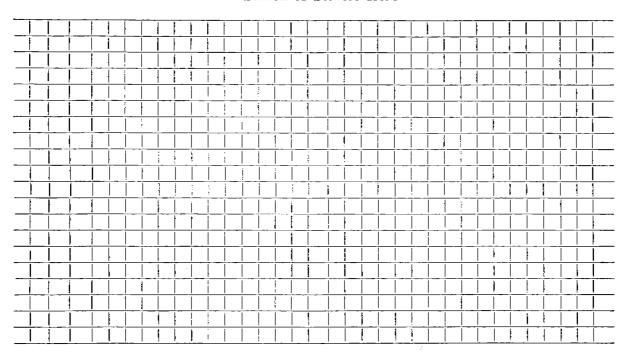

Connection made in	Street.	Work completed	
Remarks: Oxiginal. Se	rvice 11-22-27	,	
		,	
	,		