

Name Fred Hinkley

Service No. 112

Address 229 Bedford St.

Lexington

Location

Kind of Pipe

Size

Size of Main

~~Repair~~ ~~Renewal~~ ~~New Service~~

COM. 11-3-52

Location

Date	Material	Amount	Total	Date	Amount
9/30/52	Labor	38 22		8-5-52	Deposited 200 00
10/1/52	Labor	29 39		11-5-52	Refunded (8 69
10/2/52	Labor	32 66			191 31
	10% Overhead	10 03	110 30		
	56' - 6" sewer pipe @ .342		19 15		
	joint compound		3 36		
	7 hr. Littlefield shovel		49 00		
	2 hr. trucking		1 50		
	patching 8 X 3		8 00		
			191 31		
	Labor			6-16-52	No Problem with Main

**TOWN OF LEXINGTON—DEPT. OF PUBLIC WORKS
SEWER DIVISION**

DATE.....

NO.


The undersigned applies for the construction of a particular sewer connecting No.....
Street and hereby agrees to comply with the Rules and Regulations governing the construction and use of Particular
Sewers, as now or at any future time established by the Board of Selectmen.

Am't of estimate \$.

Am't Paid \$.

..... Owner

Sketch of Service Here

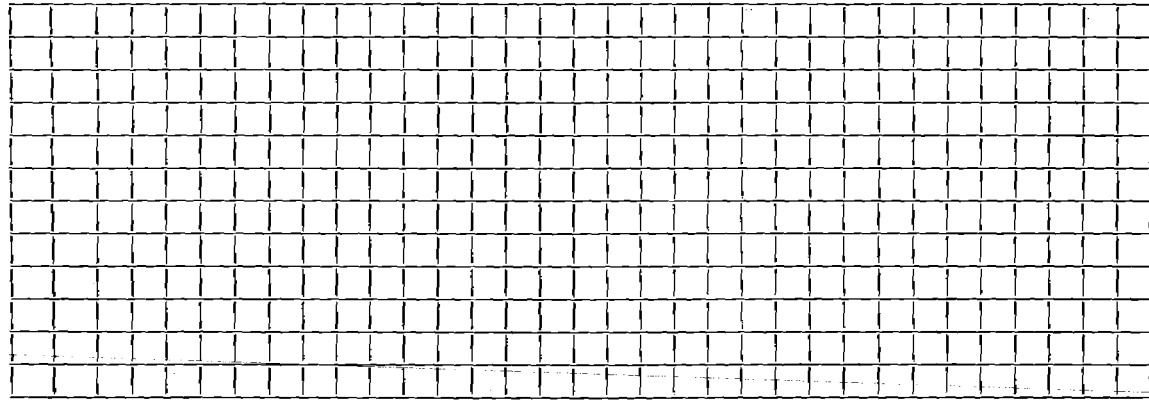

Connection made in Street.

Work completed.....19..

Remarks: