

Name **Manuel D. Freitas**Service No. **104**Address **231 Bedford St.****Lexington**

Location

Kind of Pipe

Size

Size of Main

~~Repair~~ ~~Renewal~~ ~~—~~ **New Service****COM. 11-3-52**

Location

Date	Material	Amount	Total	Date	Amount
9/29/52	Labor	41 17		7-22-52	Deposited 125 -
9/30/52	Labor	8 82		11-5-52	Refund 15 06
	10% Overhead	5 00	54 99		109 94
	26' - 6" sewer pipe @ .342		8 89		
	joint compound		1 56		
	5 hrs. Littlefield shovel		35 00		
	2 hr. trucking		1 50		
	patching 8 x 3		8 00		
			109 94		

Labor

**TOWN OF LEXINGTON—DEPT. OF PUBLIC WORKS**  
**SEWER DIVISION**

DATE.....

NO. ....

The undersigned applies for the construction of a particular sewer connecting No.....  
Street and hereby agrees to comply with the Rules and Regulations governing the construction and use of Particular  
Sewers, as now or at any future time established by the Board of Selectmen.


Am't of estimate \$.....

Am't Paid \$.....

..... Owner

---

**Sketch of Service Here**

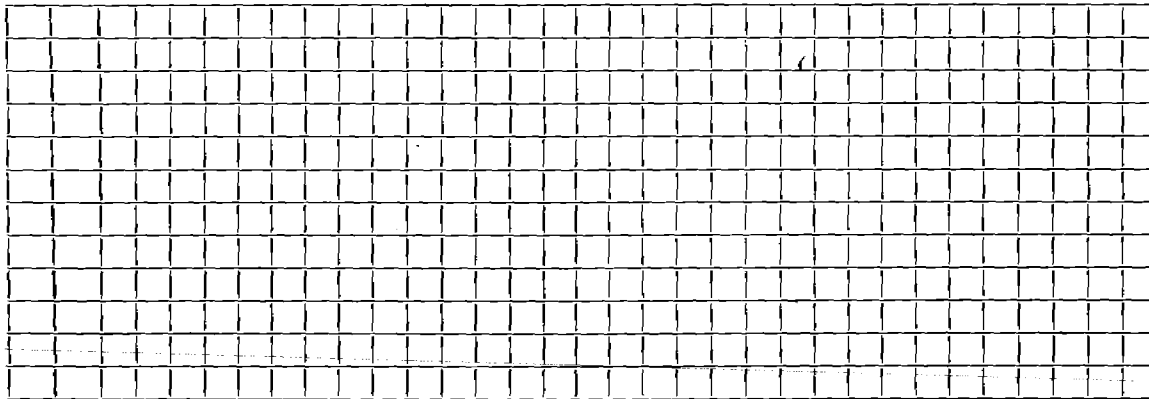

Connection made in ..... Street.

Work completed.....19..

Remarks: