

Name

Service No.

Address 234 Bedford Street

B. & M. Vacant Lot

Location

Kind of Pipe

Size

Size of Main

~~Repair~~ ~~Renewal~~ New Service

Location

Date	Material	Amount	Total	Date		Amount
5-27-59	Labor	62.59				
	10% O.H.	6.26	68.85			
	39' 6" Transite Pipe @.70		27.30			
	4 hrs. Town Shovel @ 6.50		26.00			
	3 hrs. Trucking @.75		2.25			
	15 x 3 Patch		15.00			
			139.40			
	BILL WHEN CONNECTED					
	Labor					

TOWN OF LEXINGTON—DEPT. OF PUBLIC WORKS
SEWER DIVISION

DATE.....

NO.


The undersigned applies for the construction of a particular sewer connecting No.....
Street and hereby agrees to comply with the Rules and Regulations governing the construction and use of Particular
Sewers, as now or at any future time established by the Board of Selectmen.

Am't of estimate \$.....

Am't Paid \$.....

..... Owner

Sketch of Service Here **234**

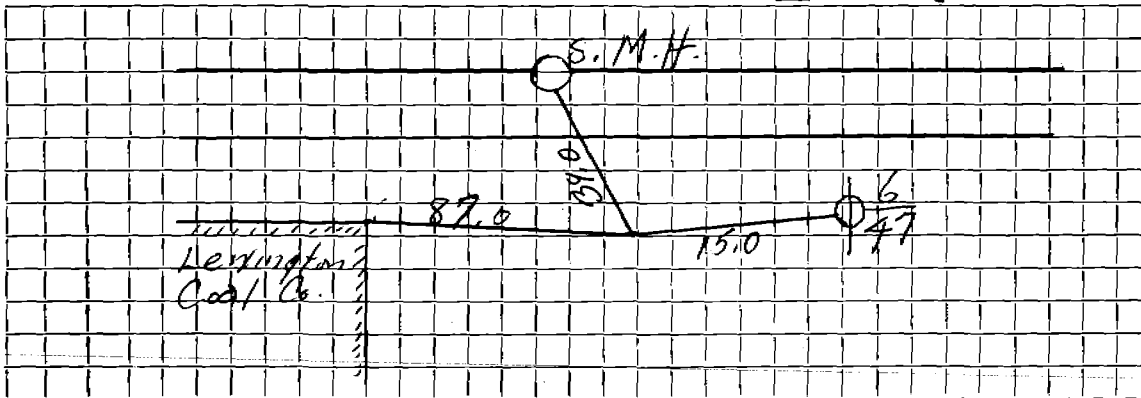

Connection made in Street.

Work completed 19..

Remarks: