

Name Arthur Mitchell

Service No. 156

Address 235 Bedford Street

Location

Kind of Pipe

Size

Size of Main

~~Repair Renewal~~ New Service

COM. 11-9-53

Location

Date	Material	Amount	Total	Date	Amount
10/6/53	Labor	79 70		8-28-53	150 00
	10% overhead	7 97	87 67	11-9-53	17 41
	40' -6" sewer pipe @ .3036		12 14		132 59
	1 - 6" elbow		1 88		
	joint compound		2 40		
	3 hrs. town shovel @ 5.00		15 00		
	2 hrs. trucking @ .75		1 50		
	patching 12 x 3		12 00		
			132 59		
	Labor				

TOWN OF LEXINGTON—DEPT. OF PUBLIC WORKS  
SEWER DIVISION

DATE .....

NO. ....


The undersigned applies for the construction of a particular sewer connecting No. .... Street and hereby agrees to comply with the Rules and Regulations governing the construction and use of Particular Sewers, as now or at any future time established by the Board of Selectmen.

Am't of estimate \$ . . . . .

Am't Paid \$ . . . . .

..... Owner

Sketch of Service Here

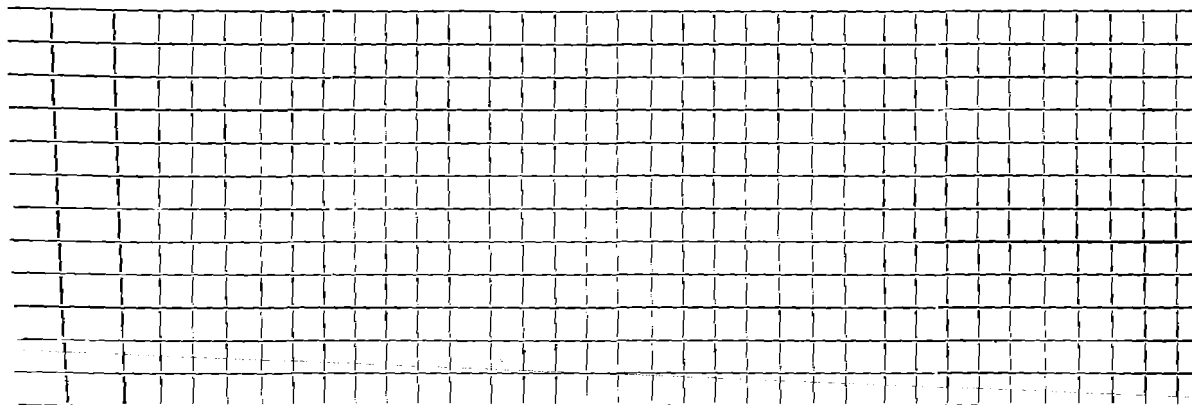

Connection made in ..... Street.

Work completed ..... 19..

Remarks: