

Name Lexington Coal & Oil Co.

Service No.

Address 240 Bedford Street

Location

Kind of Pipe

Size

Size of Main

Repair—Renewal—New Service Eagle #1407


Location

Date		Material	Amount	Total	Date		Amount
10-6-69	108'	6" Cast Iron pipe					

DATE _____

TOWN OF LEXINGTON — BOARD OF PUBLIC WORKS
SEWER DIVISION

Sketch of Service Here **240**

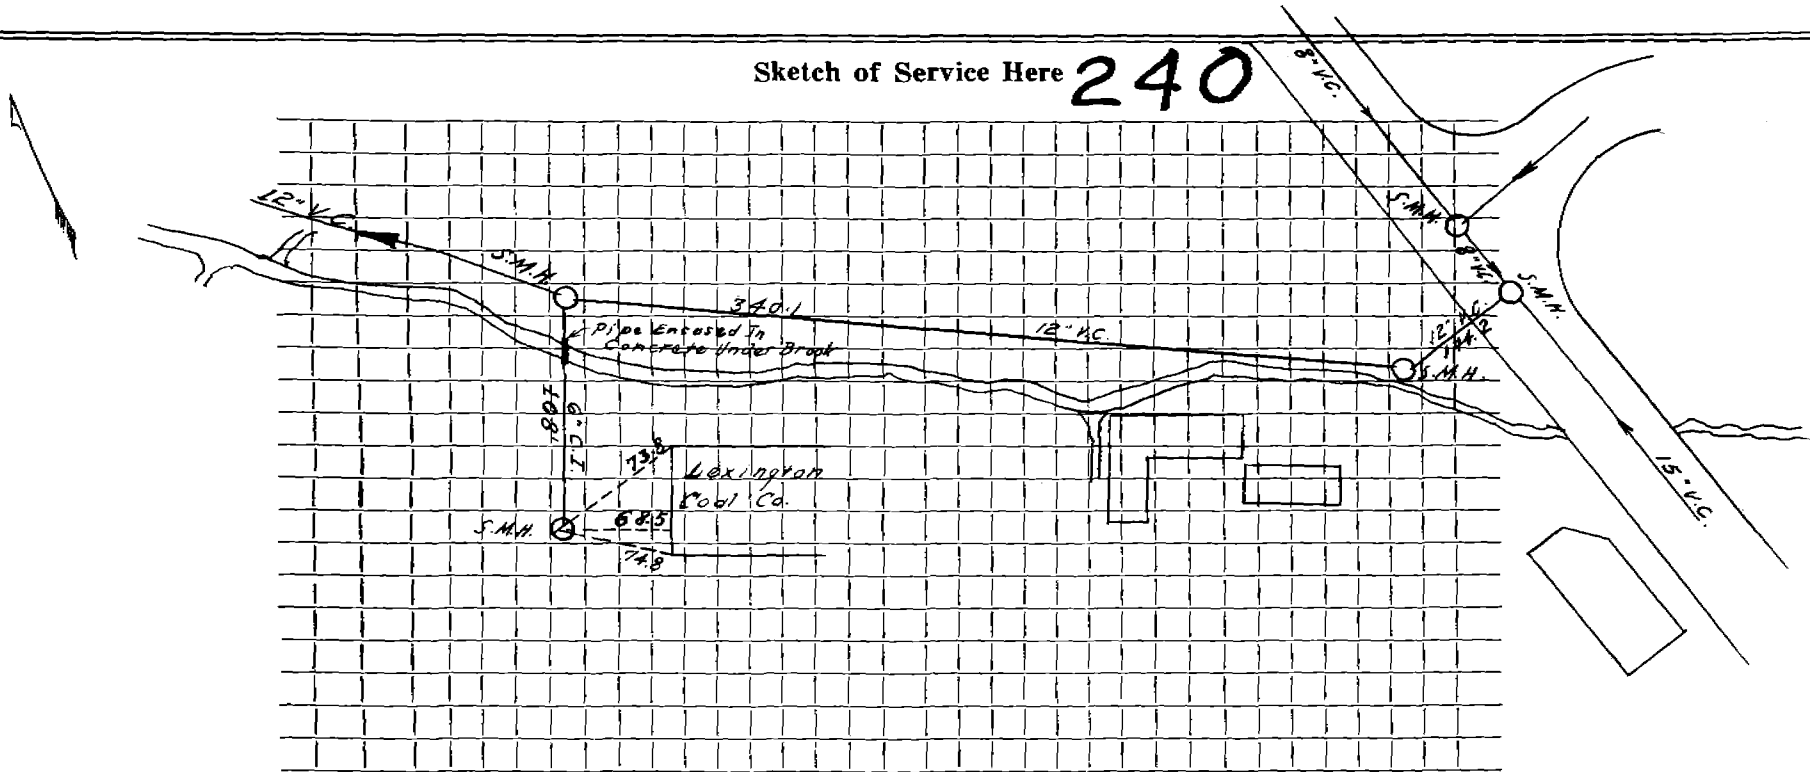

Connection made in Street. Work completed

Remarks:

.....

.....

Name

Service No.

Address *240 Bedford St.*

Location

Kind of Pipe

Size

Size of Main

Repair—Renewal—New Service


Location

Date	Material	Amount	Total	Date	Amount
------	----------	--------	-------	------	--------

DATE _____

TOWN OF LEXINGTON — BOARD OF PUBLIC WORKS

SEWER DIVISION

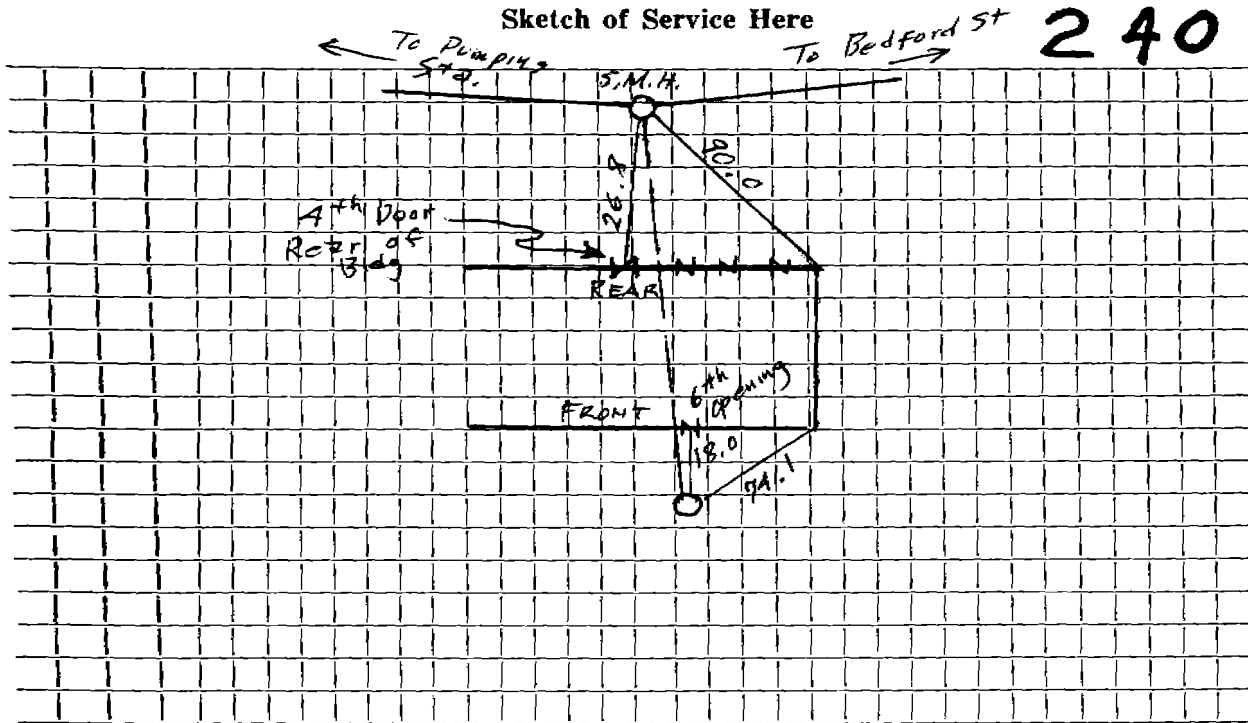

Connection made in Street. Work completed

Remarks:

.....

.....